

Marshall
K 70
6-30-75

MISSISSIPPI
BOARD OF WATER COMMISSIONERS
416 North State Street
Jackson, Mississippi 39201

CODED

WATER WELL DRILLERS LOG

6-30 1975 Dean Kent Buford Marshall
date well completed film name county well located

LANDOWNER:
Joseph R. Marion
Box 25-C
Hells Springs, Miss.
(mailing address)

description of formations encountered	from	to
<u>Clay</u>	<u>0</u>	<u>20</u>
<u>Sand</u>	<u>20</u>	<u>60</u>
<u>Clay</u>	<u>60</u>	<u>70</u>
<u>Sand</u>	<u>70</u>	<u>140</u>

WELL LOCATION:
sec. 8 T. 3 N. R. 3 E. 15E
2 miles North of Pen Banks
(distance) (direction) (nearest town)

WELL PURPOSE: Drinking
(home, irrigation, municipal, industrial)

WELL COMPLETION DATA:

(1) diameter (inches) 4"

(2) total depth (feet) 140 feet

(3) static water level (feet) 80 feet ^{below} _{above} top of ground.

(4) casing 1/2" C. 140 feet
(material) (depth)

(size) if telescope see back.

(5) screen 7 ft. 133 feet
(length) (depth to top)

4" gravel wall
(size) (material)

(6) pump 3/4 14
(HP) (yield gpm)

(type power)

(7) electric log elect.
(yes or no)

(organization running log)


(8) how well bottom plugged 4" cof.

DRILLERS REMARKS:

RECORDED
INDEXED
JUL 11 1975

If well telescopes please
sketch and show depths.

GROUND LEVEL

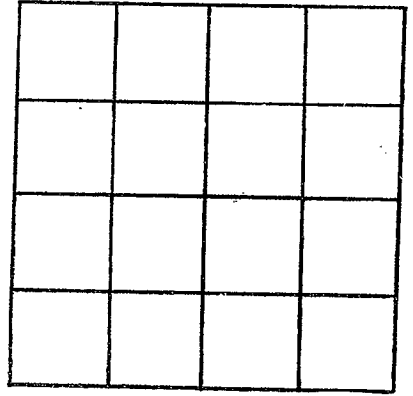

SECTION _____

Please indicate well location X.

ADDITIONAL INFORMATION

If more than one screen,
show locations of each on sketch.