

MISSISSIPPI DEPARTMENT OF NATURAL RESOURCES

Bureau of Land and Water Resources

Southport Mall

P.O. Box 10631

Jackson, Mississippi 39209

WATER WELL DRILLERS LOG

CODED

MARSHALL
K 74
10-14-81

10-14-81
date well completed

Wilson Well Co
firm name

Marshall
county well located

LANDOWNER: James Robertson

At 1 Box 298

Red Bank, Miss

(mailing address)

description of formations encountered

from to

<u>Red Clay-Red Sand</u>	<u>0</u>	<u>30</u>
<u>Red sand</u>	<u>30</u>	<u>60</u>
<u>White clay-white sand</u>	<u>60</u>	<u>90</u>
<u>White sand</u>	<u>90</u>	<u>105</u>
<u>White sand-white clay-white sand</u>	<u>105</u>	<u>120</u>
<u>White sand</u>	<u>120</u>	<u>175</u>

WELL LOCATION:

sec. 6 T. 3 N. R. 3 E.
2 miles N of Red Bank
(distance) (direction) (nearest town)

WELL PURPOSE: Home
(home, irrigation, municipal, industrial)

WELL COMPLETION DATA:

- (1) diameter (inches) 4
- (2) total depth (feet) 175
- (3) static water level (feet) 88 below top of ground.
- (4) casing Plastic (material) (depth)
4 (size) if telescope see back.
- (5) screen 10 (length) (depth to top)
4 (size) Plastic (material)
- (6) pump 5 (HP) 60 (yield gpm)
electric (type power)
- (7) electric log No (yes or no)

(organization running log)

(8) how well bottom plugged Plastic Cap

DRILLERS REMARKS:

CODED


DEPT. OF NATURAL RESOURCES
BUREAU OF LAND & WATER RESOURCES

OCT 27 1981

RECEIVED

If well telescopes please sketch and show depths.

GROUND LEVEL

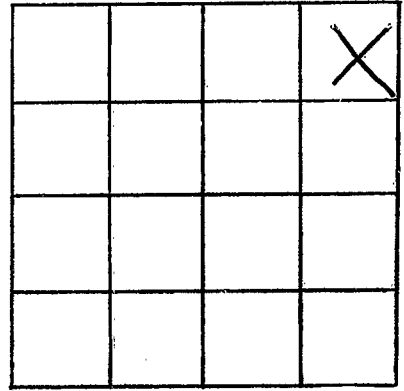

SECTION 6

Please indicate well location X.

ADDITIONAL INFORMATION

RECEIVED

81 OCT 27 AM: 55

If more than one screen, show locations of each on sketch.