

Marshall

R 2001

9/16/77

MISSISSIPPI
 BOARD OF WATER COMMISSIONERS
 416 North State Street
 Jackson, Mississippi 39201

WATER WELL DRILLERS LOG

9-16 1977 Dun Kertansey Marshall
 date well completed firm name county well located

LANDOWNER:

MRS. V. B. ATKINS

description of formations encountered

clay

from 0 to 30

Holly Springs, Miss.
(mailing address)

sand

30 180

WELL LOCATION:

sec 30 T 3 N R 3 E
 (S) (W)
2 miles N.E. of Holly Springs
 (distance) (direction) (nearest town)

WELL PURPOSE: Dwelling
(home, irrigation, municipal, industrial)

WELL COMPLETION DATA:

- (1) diameter (inches) 4"
- (2) total depth (feet) 180 feet
- (3) static water level (feet) 90 below above top of ground.
- (4) casing PVC, 180 feet
(material) (depth)

 If telescope see back.
(size)

- (5) screen 10 ft., 170 feet
(length) (depth to top)
- 4", gravel
(size) (material)

- (6) pump 3/4 14
(HP) (yield gpm)

(type power)

- (7) electric log elect.
(yes or no)

(organization running log)

- (8) how well bottom plugged 4" cap.


DRILLERS REMARKS:

RECEIVED
NOV - 4 1977

MISS. BD. OF WATER COMM

If well telescopes please sketch and show depths.

GROUND LEVEL

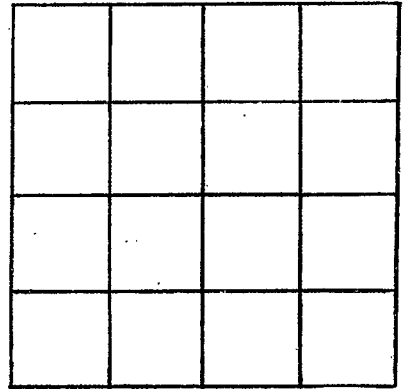

SECTION _____

Please indicate well location X.

ADDITIONAL INFORMATION

If more than one screen,
show locations of each on sketch.