

Marshall
K2004
10/3/77

MISSISSIPPI
BOARD OF WATER COMMISSIONERS
416 North State Street
Jackson, Mississippi 39201

WATER WELL DRILLERS LOG

Oct. 3 1977 Atkinson & Frost Marshall
date well completed firm name county well located

LANDOWNER: Mike Blount
Billy Springs Miss
(mailing address)

description of formations encountered	from	to
<u>Red Clay</u>	<u>0</u>	<u>31</u>
<u>Red Sand</u>	<u>25</u>	<u>50</u>
<u>White Sand</u>	<u>50</u>	<u>95</u>
<u>Clay</u>	<u>95</u>	<u>105</u>
<u>Whitesand</u>	<u>10.5</u>	<u>170</u>

WELL LOCATION:
sec. 1 T. 3 N. R. 3 E.
6 miles west of Billy Springs
(distance) (direction) (nearest town)

WELL PURPOSE: Home
(home, irrigation, municipal, industrial)

- WELL COMPLETION DATA:
- (1) diameter (inches) 4 1/2
 - (2) total depth (feet) 170
 - (3) static water level (feet) 120 below top of ground
 - (4) casing PVC 160
(material) (depth)
 - _____ if telescope see back.
(size)
 - (5) screen 160 170
(length) (depth to top)
 - 4" PVC
(size) (material)
 - (6) pump 3/4 10
(HP) (yield gpm)
 - Elec
(type power)
 - (7) electric log no
(yes or no)
 - _____ (organization running log)
 - (8) how well bottom plugged Cap.

RECEIVED


NOV 28 1977

MISS. BD. OF WATER COMM.

DRILLERS REMARKS:

If well telescopes please sketch and show depths.

GROUND LEVEL

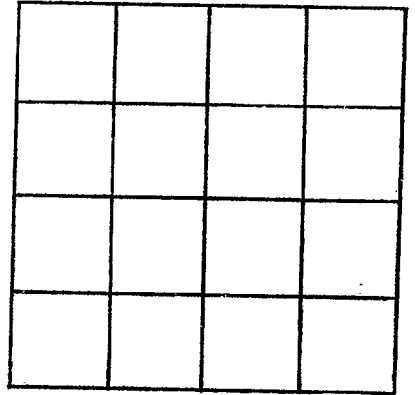

SECTION _____

Please indicate well location X.

ADDITIONAL INFORMATION

If more than one screen,
show locations of each on sketch.