

MARSHALL

K 2005

6/21/78

MISSISSIPPI BOARD OF WATER COMMISSIONERS  
416 North State Street  
Jackson, Mississippi 39201

WATER WELL DRILLERS LOG

6-21 1978  
date well completed


Dean Kent B...  
firm name

Marshall  
county well located

LANDOWNER:	description of formations encountered	from	to
Charles Thomas Holly Springs Miss (mailing address)	clay	0	20
WELL LOCATION: sec 24 T 3 N R 3 E 3 miles North of Holly Springs (distance) (direction) (nearest town)	sand	20	80
WELL PURPOSE: Drilling (home, irrigation, municipal, industrial)	clay	80	90
WELL COMPLETION DATA: (1) diameter (inches) 4" (2) total depth (feet) 210 feet (3) static water level (feet) 30 feet below top of ground. (4) casing PVC, 210 feet (material) (depth) (size) If telescope see back. (5) screen 74", 203 feet (length) (depth to top) 4", gravel wall (size) (material) (6) pump 1/2 horse, 15 (HP) (yield gpm) (type power) (7) electric log yes (yes or no) (organization running log) (8) how well bottom plugged 4" of	sand	90	210
DRILLERS REMARKS:	<p style="text-align: center;"><b>RECEIVED</b> JUL 11 1978 MISS. BD. OF WATER COMM</p>		

If well telescopes please sketch and show depths.

GROUND LEVEL

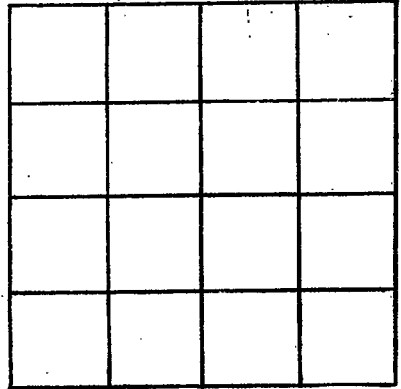

SECTION \_\_\_\_\_

Please indicate well location X.

ADDITIONAL INFORMATION

If more than one screen, show locations of each on sketch.