

Marshall  
 R 2006  
 11-8-79

MISSISSIPPI  
 BOARD OF WATER COMMISSIONERS  
 416 North State Street  
 Jackson, Mississippi 39201


WATER WELL DRILLERS LOG

11-8 date well completed 19 79 Nichols Well Co. firm name Marshall county well located

LANDOWNER:	description of formations encountered	from	to
Oscar Lee Fant Rt. 3, Box 508 - W. S. (mailing address)	clay	0	20
WELL LOCATION: sec. 28 T 3 N R 3 E 6 3/4 miles West of Lily Springs (distance) (direction) (nearest town)	red sand	20	70
WELL PURPOSE: home (home, irrigation, municipal, industrial)	white sand	70	170
WELL COMPLETION DATA: (1) diameter (inches) 4 1/2 in (2) total depth (feet) 170 (3) static water level (feet) 120 below above top of ground. (4) casing Plastic 170 (material) (depth) (size) if telescope see back. (5) screen 7 ft 163 (length) (depth to top) 4 in Gravel (size) (material) (6) pump 1/2 10 (HP) (yield gpm) 220 (type power) (7) electric log No (yes or no) (organization running log) (8) how well bottom plugged cap			
DRILLERS REMARKS:	DEPT. OF NATURAL RESOURCES BUREAU OF LAND & WATER RESOURCES DEC 10 1979 RECEIVED		

If well telescopes please sketch and show depths.

GROUND LEVEL

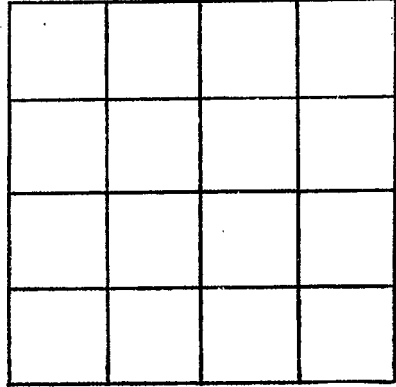

SECTION \_\_\_\_\_

Please indicate well location X.

ADDITIONAL INFORMATION

If more than one screen, show locations of each on sketch.