

MARSHALL

MISSISSIPPI
BOARD OF WATER COMMISSIONERS
416 North State Street
Jackson, Mississippi 39201

K 2007
6-11-80

WATER WELL DRILLERS LOG

6-11 date well completed 19 30 Hicks Wells Co. firm name Marshall county well located

LANDOWNER:
James Ray
Holly Springs
(mailing address)

description of formations encountered	from	to
Clay	0	30
red sand	30	150
white sand	150	245

WELL LOCATION:
sec. 34 T 3 N R 3 E
5 miles W of Holly Springs
(distance) (direction) (nearest town)

WELL PURPOSE: home
(home, irrigation, municipal, industrial)

WELL COMPLETION DATA:

(1) diameter (inches) 4 in

(2) total depth (feet) 245

(3) static water level (feet) 200 below top of ground.

(4) casing Plastic 245
(material) (depth)

(size) If telescope see back.

(5) screen 7 ft 238
(length) (depth to top)
4 in brass
(size) (material)

(6) pump 1/2 10
(HP) (yield gpm)
220
(type power)

(7) electric log No
(yes or no)

(organization running log)

(8) how well bottom plugged Cap

DRILLERS REMARKS:


DEPT. OF NATURAL RESOURCES
BUREAU OF LAND & WATER RESOURCES

JUN 25 1980

RECEIVED

If well telescopes please sketch and show depths.

GROUND LEVEL

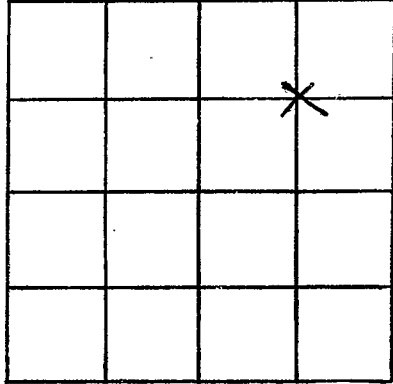

SECTION 34

Please indicate well location X.

ADDITIONAL INFORMATION

If more than one screen,
show locations of each on sketch.