

Marshall  
 R 2010  
 9-7-76

MISSISSIPPI  
 BOARD OF WATER COMMISSIONERS  
 416 North State Street  
 Jackson, Mississippi 39201

WATER WELL DRILLERS LOG

9-7-76 date well completed  
 Dean Hunt & Sons firm name  
 Marshall county well located

LANDOWNER:  
 Richard Raenes  
 Holly Springs, Miss.  
 (mailing address)

description of formations encountered	from	to
clay	0	20
sand	20	140

WELL LOCATION:  
 sec. 32 T. 3 N. R. 3 E  
 5 miles West of N.S.  
 (distance) (direction) (nearest town)

clay	140	145
sand	145	230

WELL PURPOSE: Drinking  
 (home, irrigation, municipal, industrial)

WELL COMPLETION DATA:

(1) diameter (inches) 4"

(2) total depth (feet) 230 feet

(3) static water level (feet) 140 below above top of ground.

(4) casing PVC 230 feet  
 (material) (depth)

(size) If telescope see back.

(5) screen 7 ft. 233 feet  
 (length) (depth to top)

4" gravel wall  
 (size) (material)

(6) pump 3/4 14  
 (HP) (yield gpm)

(type power)

(7) electric log Elect.  
 (yes or no)

(organization running log)

(8) how well bottom plugged 4" cap.


RECEIVED  
 OCT - 5 1976

MISS. BD. OF WATER COMMISSIONERS

DRILLERS REMARKS:

If well telescopes please sketch and show depths.

GROUND LEVEL

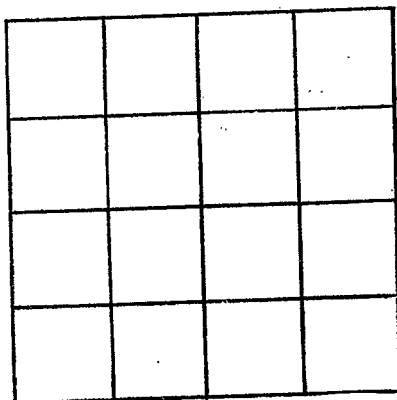

SECTION \_\_\_\_\_

Please indicate well location X.

ADDITIONAL INFORMATION

If more than one screen, show locations of each on sketch.