

Marshall
K 2012
12/18/76

MISSISSIPPI
BOARD OF WATER COMMISSIONERS
416 North State Street
Jackson, Mississippi 39201

WATER WELL DRILLERS LOG

Dec 18 1976 Earl Jones Well Co Marshall
date well completed firm name county well located


LANDOWNER:	description of formations encountered	from	to
Joe T. Sester			
Holly Springs Miss. RT. (mailing address)	Topsoil of clay sand clay sand clay sand	0 16 60 65 144 160	16 20 65 144 160 208
WELL LOCATION: sec. 33 T 3 N R 32 E W 3 1/2 miles S of Holly Springs (distance) (direction) (nearest town)			
WELL PURPOSE: Home (home, irrigation, municipal, industrial)			
WELL COMPLETION DATA:			
(1) diameter (inches) 4"			
(2) total depth (feet) 208			
(3) static water level (feet) 135 below top of ground.			
(4) casing plastic 198 (material) (depth) 4" if telescope see back. (size)			
(5) screen 10' 198 (length) (depth to top) 0.13" plastic (size) (material)			
(6) pump 3/4 15 (HP) (yield gpm) electric (type power)			
(7) electric log no. (yes or no) (organization running log)			
(8) how well bottom plugged plastic cap			
DRILLERS REMARKS:			

RECEIVED
DEC 21 1976

MISS. BD. OF WATER COMMISSIONERS

If well telescopes please sketch and show depths.

GROUND LEVEL

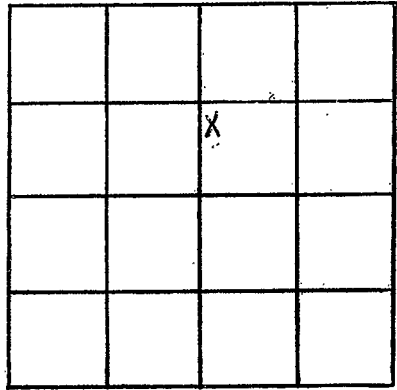

SECTION 33

Please indicate well location X.

ADDITIONAL INFORMATION

If more than one screen, show locations of each on sketch.