

MARSHALL

K 2013

June 4, 1977

MISSISSIPPI BOARD OF WATER COMMISSIONERS

416 North State Street

15E Jackson, Mississippi 39201

WATER WELL DRILLERS LOG

June 4 date well completed

15E Earl Jones Well Co firm name

Marshall county well located

LANDOWNER:

Charlie Sheed

Holly Springs Miss (mailing address)

WELL LOCATION:

33 sec. 3 T 3 R 3 S W 4 miles (distance) W. of Holly Springs (nearest town)

WELL PURPOSE: Home (home, irrigation, municipal, industrial)

WELL COMPLETION DATA:

- (1) diameter (inches) 4"
(2) total depth (feet) 208
(3) static water level (feet) 180 below top of ground.
(4) casing plastic, 198 (material) (depth) 4" (size) - If telescope see back.
(5) screen 10' 198 (length) (depth to top) 4" - 013 (size) plastic (material)
(6) pump 3/4 12 (HP) (yield gpm) Electric (type power)
(7) electric log no (yes or no)
(organization running log)

(8) how well bottom plugged: Plastic caps

DRILLERS REMARKS:

description of formations encountered

from to

Table with 3 columns: description of formations encountered, from, to. Rows include: Topsoil & clay (0-12), sand (12-42), clay (42-46), sand (46-80), clay (80-85), sand (85-180), clay (180-187), sand (187-208).


RECEIVED stamp

JUL 5 1977 stamp

MISS. BD. OF WATER COMMISSIONERS stamp

If well telescopes please sketch and show depths.

GROUND LEVEL

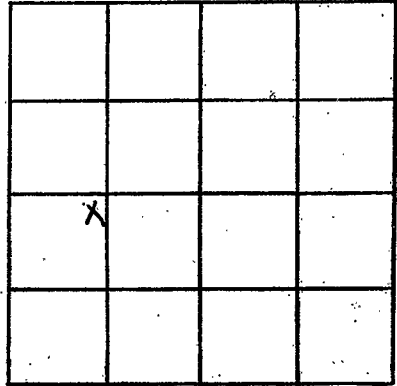

SECTION 33

Please indicate well location X.

ADDITIONAL INFORMATION

If more than one screen, show locations of each on sketch.