

MARSHALL
K 2015
7-28-77

MISSISSIPPI
 BOARD OF WATER COMMISSIONERS
 416 North State Street
 Jackson, Mississippi 39201

WATER WELL DRILLERS LOG

7-28-77 19 Hicks Well Co Marshall
 date well completed firm name county well located

LANDOWNER: Robert S. Jones
PT-3 Holly Springs
 (mailing address)
 WELL LOCATION:
 sec. 28 T. 3 N R. 3 E
4 miles NW of Holly Springs
 (distance) (direction) (nearest town)

description of formations encountered	from to	
	ft	ft
<u>Red Clay</u>	<u>0</u>	<u>40</u>
<u>Unconsol. & Clay</u>	<u>40</u>	<u>160</u>
<u>Red to Sand</u>	<u>160</u>	<u>200</u>

WELL PURPOSE: Home
 (home, irrigation, municipal, industrial)

WELL COMPLETION DATA:

(1) diameter (inches) 4"

(2) total depth (feet) 200

(3) static water level (feet) 160 below above top of ground.

(4) casing PVC 193
 (material) (depth)
 if telescope see back.
 (size)

(5) screen 7' 7'
 (length) (depth to top)
4" basalt rock
 (size) (material)

(6) pump 3/4 10
 (HP) (yield gpm)
Elec
 (type power)

(7) electric log
 (yes or no)

 (organization running log)

(8) how well bottom plugged Cap


RECEIVED
 AUG 28 1977

DRILLERS REMARKS:

MISSISSIPPI BOARD OF WATER COMMISSIONERS

If well telescopes please sketch and show depths.

GROUND LEVEL

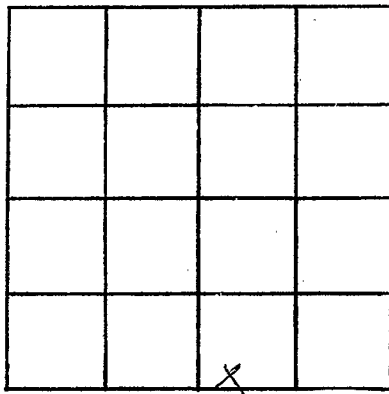

SECTION _____

Please indicate well location X.

ADDITIONAL INFORMATION

A series of horizontal lines providing space for additional information.

If more than one screen, show locations of each on sketch.