

MARSHALL  
 K 2018  
 8-18-78

MISSISSIPPI  
 BOARD OF WATER COMMISSIONERS  
 416 North State Street  
 Jackson, Mississippi 39201

WATER WELL DRILLERS LOG

8-18 1978 Dunnet Gulfport Marshall  
 date well completed firm name county well located

| LANDOWNER:           | description of formations encountered | from | to  |
|----------------------|---------------------------------------|------|-----|
| (mailing address)    |                                       |      |     |
| Charles Hodrese      | Clay                                  | 0    | 20  |
| Holly Springs, Miss. | Sand                                  | 20   | 180 |

WELL LOCATION:  
 sec. 18 T 3 N R 3 E  
 7 miles west of P.S.  
 (distance) (direction) (nearest town)

WELL PURPOSE: Drinking  
 (home, irrigation, municipal, industrial)

WELL COMPLETION DATA:

(1) diameter (inches) 4"

(2) total depth (feet) 180 feet

(3) static water level (feet) 126 below above top of ground.

(4) casing PVC 180 feet  
 (material) (depth)  
 (size) If telescope see back.


(5) screen 13 feet 167  
 (length) (depth, to top)  
4" gravel  
 (size) (material)

(6) pump 3/4 14  
 (HP) (yield gpm)  
 (type power)

(7) electric log Lead  
 (yes or no)  
 (organization running log)

(8) how well bottom plugged 4" cfb


DRILLERS REMARKS:

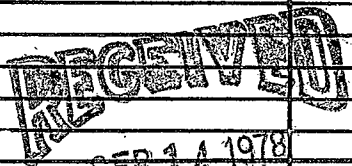

MISS. BD. OF WATER COMM.

If well telescopes please sketch and show depths.

GROUND LEVEL

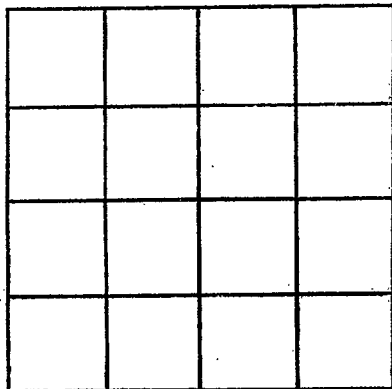

SECTION \_\_\_\_\_

Please indicate well location X.

ADDITIONAL INFORMATION

If more than one screen, show locations of each on sketch.