

MARSHALL  
 K 2019  
 9-22-78

MISSISSIPPI  
 BOARD OF WATER COMMISSIONERS  
 416 North State Street  
 Jackson, Mississippi 39201

WATER WELL DRILLERS LOG

9-22-78 date well completed      Hicks Well Co firm name      Marshall county well located

LANDOWNER: William Brown      description of formations encountered      from      to

Holly Springs, Ms. (mailing address)      Red clay      0      10


WELL LOCATION:  
 sec. 29 T 3 N R 3 E  
5 miles W of Holly Springs (distance) (direction) (nearest town)  
 Red Sand & Clay 10 100  
 Red clay + white sand 110 140  
 white sand 140 200

WELL PURPOSE: Home  
 (home, irrigation, municipal, industrial)

WELL COMPLETION DATA:  
 (1) diameter (inches) 4  
 (2) total depth (feet) 200  
 (3) static water level (feet) 80 below top of ground.  
 (4) casing PVC, 200 (material) (depth)  
 (size) If telescope see back.  
 (5) screen 4', 193 (length) (depth to top)  
4 gravel type (size) (material)  
 (6) pump 1/2, 10 (HP) (yield gpm)  
220V (type power)  
 (7) electric log No (yes or no)


(organization running log)  
 (8) how well bottom plugged Cap

DRILLERS REMARKS:  
 MISS. BD. OF WATER COMM

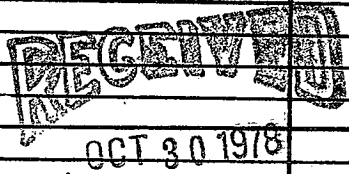

If well telescopes please sketch and show depths.

GROUND LEVEL

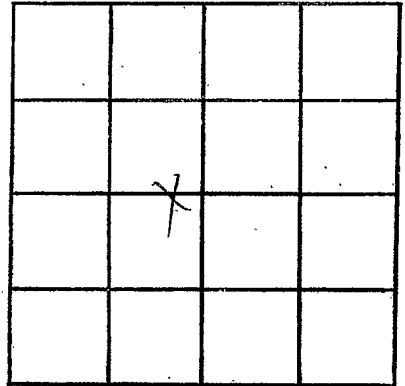

SECTION 29

Please indicate well location X.

ADDITIONAL INFORMATION

If more than one screen,  
show locations of each on sketch.