

MARSHALL
 K 2020
 10-10-78

MISSISSIPPI
 BOARD OF WATER COMMISSIONERS
 416 North State Street
 Jackson, Mississippi 39201

WATER WELL DRILLERS LOG

10-10 1978 Dean Hart Smith Marshall
 date well completed firm name county well located

LANDOWNER:	description of formations encountered	from	to
Willie Anderson			
Red Banks, Miss (mailing address)	Sand	30	60
WELL LOCATION:	clay	60	80
sec. 8 T. 3 N. R. 3 E. 3 miles north of Red Banks	Sand	80	140
(distance) (direction) (nearest town)	clay	140	180
WELL PURPOSE: <u>Drinking</u> (home, irrigation, municipal, industrial)	Sand	180	210

- WELL COMPLETION DATA:
- (1) diameter (inches) 4"
 - (2) total depth (feet) 210 feet
 - (3) static water level (feet) 110 below above top of ground.
 - (4) casing PVC 210
(material) (depth)
 - (size) If telescope see back.
 - (5) screen 74 203
(length) (depth to top)
 - 4" Granite
(size) (material)
 - (6) pump 1 15
(HP) (yield gpm)
 - (type power)
 - (7) electric log Elect.
(yes or no)
 - (organization running log)
 - (8) how well bottom plugged 4' cap


RECEIVED
 NOV 17 1978

DRILLERS REMARKS:

MISS. BD. OF WATER COMMISSIONERS

If well telescopes please sketch and show depths.

GROUND LEVEL

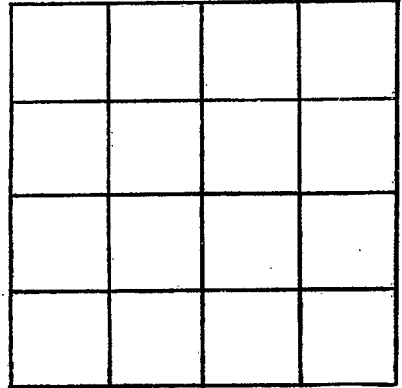

SECTION _____

Please indicate well location X.

ADDITIONAL INFORMATION

If more than one screen, show locations of each on sketch.