

MARSHALL
K 2021
03-14-79

**MISSISSIPPI  
BOARD OF WATER COMMISSIONERS**  
416 North State Street  
Jackson, Mississippi 39201

**WATER WELL DRILLERS LOG**

March 14, 1979 Earl Jones Well Co. Marshall  
 date well completed firm name county well located

LANDOWNER:	description of formations encountered	from	to
<u>George D. Martin</u> <u>Red Banks Miss.</u> (mailing address)			
<b>WELL LOCATION:</b> sec <u>18</u> T <u>3</u> N R <u>3</u> E <u>1/8</u> miles <u>S</u> of <u>Red Banks</u> (distance) (direction) (nearest town)	<u>sand</u>	<u>14</u>	<u>44</u>
<b>WELL PURPOSE:</b> <u>Home</u> (home, irrigation, municipal, industrial)	<u>clay</u>	<u>44</u>	<u>47</u>
<b>WELL COMPLETION DATA:</b>	<u>sand</u>	<u>47</u>	<u>38</u>
(1) diameter (inches) <u>4"</u>	<u>clay</u>	<u>38</u>	<u>94</u>
(2) total depth (feet) <u>165</u>	<u>sand</u>	<u>94</u>	<u>165</u>
(3) static water level (feet) <u>25</u> below above top of ground.			
(4) casing <u>plastic</u> <u>155</u> (material) (depth) <u>4"</u> If telescope see back. (size)			
(5) screen <u>10'</u> <u>155</u> (length) (depth to top)			
(6) pump <u>1 1/2</u> <u>30</u> (HP) (yield gpm) <u>Electric</u> (type power)			
(7) electric log <u>no</u> (yes or no)			
(8) how well bottom plugged <u>plastic cap</u>			
DRILLERS REMARKS:			


Miss. Board of Water Comm.

APR 16 1979

**RECEIVED**

If well telescopes please sketch and show depths.

GROUND LEVEL

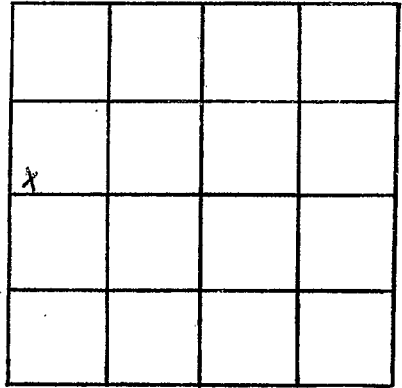

SECTION 18

Please indicate well location X.

ADDITIONAL INFORMATION

If more than one screen,  
show locations of each on sketch.