

MARSHALL
K 2022
12-15-76

**MISSISSIPPI
BOARD OF WATER COMMISSIONERS**
416 North State Street
Jackson, Mississippi 39201

WATER WELL DRILLERS LOG

Dec. 15 19 76 R. L. Carpenter Marshall
date well completed firm name county well located

LANDOWNER: <u>Larry Crase</u> <u>Holly Springs</u> <u>Miss.</u> (mailing address)	description of formations encountered	from	to
WELL LOCATION: sec. <u>26</u> T- <u>3</u> N R- <u>3</u> E <u>S</u> <u>W</u> <u>4</u> miles <u>west</u> of <u>Holly Springs</u> (distance) (direction) (nearest town)	<u>Surface soil</u>	<u>0</u>	<u>18</u>
	<u>Med. Red Sand</u>	<u>18</u>	<u>58</u>
WELL PURPOSE: <u>Home</u> (home, irrigation, municipal, industrial)	<u>Fine white sand</u>	<u>58</u>	<u>126</u>
	<u>White clay</u>	<u>126</u>	<u>153</u>
WELL COMPLETION DATA: (1) diameter (inches) <u>4</u> (2) total depth (feet) <u>198</u> (3) static water level (feet) <u>152</u> below above top of ground. (4) casing <u>Plastic</u> , <u>184'</u> (material) (depth) (size) if telescope see back. (5) screen <u>6'</u> , <u>184'</u> (length) (depth to top) <u>4"</u> , <u>Plastic & Brass</u> (size) (material) (6) pump <u>3/8</u> , <u>18</u> (HP) (yield gpm) <u>Elm.</u> (type power) (7) electric log <u>No.</u> (yes or no) (organization running log) (8) how well bottom plugged <u>PVC Cap</u>	<u>Fine white sand</u>	<u>153</u>	<u>165</u>
	<u>White coarse sand</u>	<u>165</u>	<u>198</u>
DRILLERS REMARKS:			


Miss. Board of Water Comm.

MAR 12 1979

RECEIVED

If well telescopes please sketch and show depths.

GROUND LEVEL

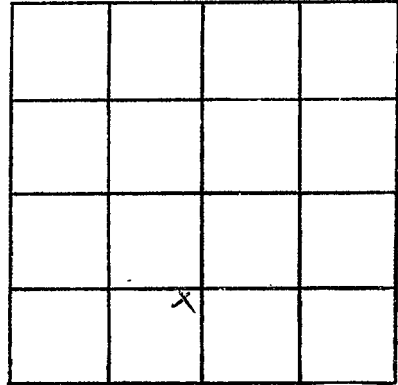

SECTION 20

Please indicate well location X.

ADDITIONAL INFORMATION

If more than one screen,
show locations of each on sketch.