

MARSHALL  
K 2023  
5-9-79

MISSISSIPPI  
 BOARD OF WATER COMMISSIONERS  
 416 North State Street  
 Jackson, Mississippi 39201

WATER WELL DRILLERS LOG


5-9 19 79 Dean Hart Bumpers Marshall  
 date well completed firm name county well located

LANDOWNER:	description of formations encountered	from	to
<u>Joe Lee Stevenson</u> <u>Nancy Springs Mrs.</u> (mailing address)			
<b>WELL LOCATION:</b>			
sec. <u>21</u> T. <u>3</u> N. R. <u>3</u> E. <u>5</u> miles <u>West</u> of <u>Holly Springs</u> (distance) (direction) (nearest town)			
<b>WELL PURPOSE:</b> <u>Domestic</u> (home, irrigation, municipal, industrial)			
<b>WELL COMPLETION DATA:</b>			
(1) diameter (inches) <u>4"</u>			
(2) total depth (feet) <u>160 feet</u>			
(3) static water level (feet) <u>120</u> below above top of ground.			
(4) casing <u>PVC</u> , <u>160 feet</u> (material) (depth)			
(size) If telescope see back.			
(5) screen <u>7ft.</u> , <u>153 feet</u> (length) (depth to top)			
<u>4"</u> , <u>gravel</u> (size) (material)			
(6) pump <u>3/4</u> , <u>14</u> (HP) (yield gpm)			
(type power)			
(7) electric log <u>slat.</u> (yes or no)			
(organization running log)			
(8) how well bottom plugged <u>4" cap.</u>			
<b>DRILLERS REMARKS:</b>			

Miss. Board of Water Comm.  
 MAY 21 1979  
 RECEIVED

If well telescopes please sketch and show depths.

GROUND LEVEL

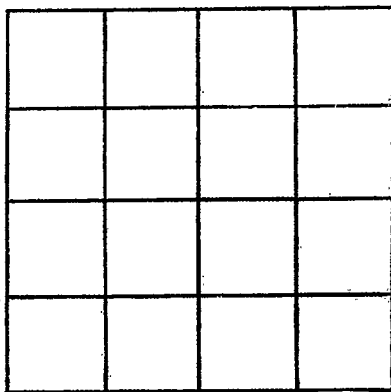

SECTION \_\_\_\_\_

Please indicate well location X.

ADDITIONAL INFORMATION

If more than one screen, show locations of each on sketch.