

Marshall

MISSISSIPPI  
BOARD OF WATER COMMISSIONERS  
416 North State Street  
Jackson, Mississippi 39201

K 2025  
2-20-78

WATER WELL DRILLERS LOG

Feb. 20 1978 R. L. Carpenter Marshall  
date well completed firm name county well located

LANDOWNER: Donell Feather  
Holly Springs  
Miss.  
(mailing address)

description of formations encountered	from	to
Surface Soil	0	19
Med Red Sand	19	40
Red Clay	40	78
White Clay	78	110
Med. White Sand	110	135
Fine White Sand	135	190
White Coars. Sand	190	232

WELL LOCATION:  
sec. 34 T. 3 N. R. 3 E.  
(S) (W)  
3 miles West of Holly Springs  
(distance) (direction) (nearest town)

WELL PURPOSE: None  
(home, irrigation, municipal, industrial)

- WELL COMPLETION DATA:
- (1) diameter (inches) 4
  - (2) total depth (feet) 232
  - (3) static water level (feet) 170 below above top of ground.
  - (4) casing Plastic, 222 ft  
(material) (depth)  
(size) if telescope see back.
  - (5) screen 18', 222'  
(length) (depth to top)  
4", Plastic  
(size) (material)
  - (6) pump 3/4, 10  
(HP) (yield gpm)  
Elec.  
(type power)
  - (7) electric log no.  
(yes or no)
  - (organization running log)
  - (8) how well bottom plugged PVC Cap

DRILLERS REMARKS:


DEPT. OF NATURAL RESOURCES  
BUREAU OF LAND & WATER RESOURCES

JUL 23 1980

RECEIVED

If well telescopes please sketch and show depths.

GROUND LEVEL

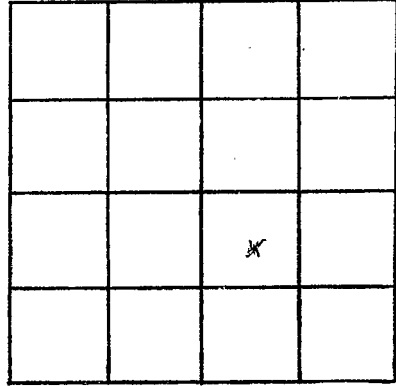

SECTION 34

Please indicate well location X.

ADDITIONAL INFORMATION

If more than one screen,  
show locations of each on sketch.