

MISSISSIPPI DEPARTMENT OF NATURAL RESOURCES

Bureau of Land and Water Resources

Southport Mall

P.O. Box 10631

Jackson, Mississippi 39209

WATER WELL DRILLERS LOG

HICKS WELL COMPANY

K 2027  
Marshall  
7-16-85

7-16-1985  
date well completed

PT. 1 BOX 157  
firm name  
SEMIATRIA MISS

Marshall  
county well located

LANDOWNER: Nell Owens

Rt # 4 Box 834

Byholia MS 38811  
(mailing address)

WELL LOCATION:

sec. 28 T. 3 N. R. 3 E  
4 miles E of Holly Springs  
(distance) (direction) (nearest town)

WELL PURPOSE: Home  
(home, irrigation, municipal, industrial)

WELL COMPLETION DATA:

- (1) diameter (inches) 4"
- (2) total depth (feet) 215'
- (3) static water level (feet) 180 below above  
top of ground.
- (4) casing PVC, 205'  
(material) (depth)  
4" If telescope see back.  
(size)
- (5) screen 10', 205'  
(length) (depth to top)  
1013, PVC  
(size) (material)
- (6) pump 3/4, 10  
(HP) (yield gpm)  
220 V  
(type power)
- (7) electric log NO  
(yes or no)
- (organization running log)
- (8) how well bottom plugged Cap

description of formations encountered

from to

Red clay 0 10

Red Sand 10 50

White Sand & clay 50 90

White Sand 90 215


RECEIVED  
OCT 17 1985

DRILLERS REMARKS:

Department of Natural Resources  
Bureau of Land & Water Resources

If well telescopes please sketch and show depths.

GROUND LEVEL

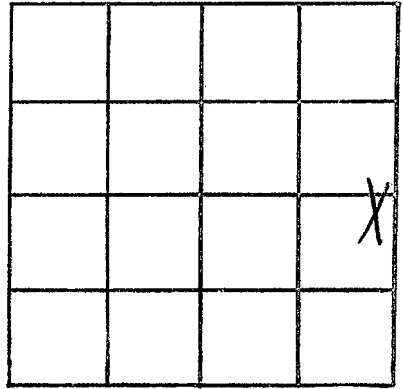

SECTION 28

Please indicate well location X.

ADDITIONAL INFORMATION

If more than one screen, show locations of each on sketch.