

Marshall  
 K 2028  
 9-8-80

MISSISSIPPI  
 BOARD OF WATER COMMISSIONERS  
 416 North State Street  
 Jackson, Mississippi 39201

WATER WELL DRILLERS LOG

9-8-80 date well completed  
 Hick Well Co. firm name  
 Marshall county well located

LANDOWNER:	description of formations encountered	from	to
Elizabeth King Rt. 3, Box 49 Hick Springs, MS. (mailing address)	Red Clay White Sand	0	15
<b>WELL LOCATION:</b>			
sec. 26 T. 3 N. R. 3 E. 2 miles W of Hick Springs			
<b>WELL PURPOSE:</b> (home, irrigation, municipal, industrial)			
<b>WELL COMPLETION DATA:</b>			
(1) diameter (inches) 4"			
(2) total depth (feet) 155			
(3) static water level (feet) 80 below above top of ground.			
(4) casing PVC 155 (material) (depth)			
(size) if telescope see back.			
(5) screen 7' 148 (length) (depth to top)			
4" annular seal (size) (material)			
(6) pump 1/2 70 (HP) (yield gpm)			
220V (type power)			
(7) electric log No (yes or no)			
(organization running log)			
(8) how well bottom plugged Cap			

DRILLERS REMARKS:


DEPT. OF NATURAL RESOURCES  
 BUREAU OF LAND & WATER RESOURCES

SEP 29 1980

RECEIVED

If well telescopes please sketch and show depths.

GROUND LEVEL

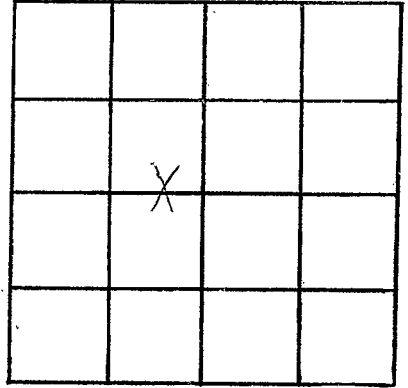

SECTION 26

Please indicate well location X.

ADDITIONAL INFORMATION

If more than one screen,  
show locations of each on sketch.