

Marshall
K 2029
5/16/79

MISSISSIPPI
 BOARD OF WATER COMMISSIONERS
 416 North State Street
 Jackson, Mississippi 39201

WATER WELL DRILLERS LOG

May 16 19 79 R. D. Carpenter Marshall
 date well completed firm name county well located

LANDOWNER: Olle M. Cary
Holly Springs, Miss
R. F. D.
 (mailing address)

description of formations encountered

description of formations encountered	from	to
Surface soil	0	19
Med. Red sand	19	45
Med. White sand	45	80
White Clay	80	84
White Fine sand	84	120
White Clay	120	135
Med. White sand	135	180
White Coarse sand	180	230

WELL LOCATION:
 sec. 35 T 3 N R 3 E
1 1/2 miles West of Holly Springs
 (distance) (direction) (nearest town)

WELL PURPOSE: Plumber
 (home, irrigation, municipal, industrial)

WELL COMPLETION DATA:

(1) diameter (inches) 4

(2) total depth (feet) 230

(3) static water level (feet) 183 below top of ground.

(4) casing Plastic, 2 1/2"
 (material) (depth)

(size) if telescope see back.

(5) screen 10", 220"
 (length) (depth to top)

4", Plastic
 (size) (material)

(6) pump 3/4 10
 (HP) (yield gpm)

Class
 (type power)

(7) electric log no
 (yes or no)

(organization running log)


(8) how well bottom plugged PVC cap

DEPT. OF NATURAL RESOURCES
 BUREAU OF LAND & WATER RESOURCES
 MAY 18 1981
 RECEIVED

DRILLERS REMARKS:

If well telescopes please sketch and show depths.

GROUND LEVEL

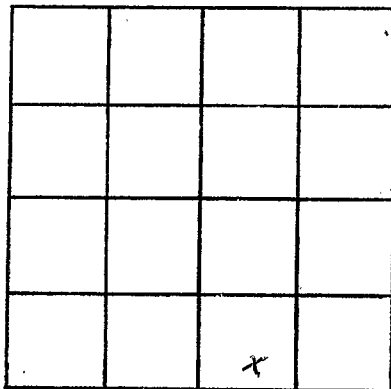

SECTION 35

Please indicate well location X.

ADDITIONAL INFORMATION

A series of horizontal lines for writing additional information.

If more than one screen, show locations of each on sketch.