

MISSISSIPPI DEPARTMENT OF NATURAL RESOURCES

Bureau of Land and Water Resources

Southport Mall

P.O. Box 10631

Jackson, Mississippi 39209

WATER WELL DRILLERS LOG

MARSHALL
K 2036
9-3-80

9-3 1980 Dean Kent B. Edwards Marshall
 date well completed firm name county well located

LANDOWNER:	description of fomations encountered	from	to
<u>Lillian Cochran</u>			
<u>Holly Springs, Miss.</u> (mailing address)	<u>Sand</u>	<u>20</u>	<u>25</u>
WELL LOCATION:	<u>Rock</u>	<u>25</u>	<u>30</u>
sec. <u>28</u> T. <u>3</u> N. R. <u>3</u> E. W. <u>1</u>	<u>Sand</u>	<u>30</u>	<u>200</u>
<u>5</u> miles <u>west</u> of <u>Holly Springs</u> (distance) (direction) (nearest town)			
WELL PURPOSE: <u>Residence</u> (home, irrigation, municipal, industrial)			
WELL COMPLETION DATA:			
(1) diameter (inches) <u>4"</u>			
(2) total depth (feet) <u>200 feet</u>			
(3) static water level (feet) <u>155</u> below top of ground.			
(4) casing <u>pvc</u> , <u>200 feet</u> (material) (depth)			
(size) if telescope see back.			
(5) screen <u>7 ft.</u> , <u>183 feet</u> (length) (depth to top)			
<u>4"</u> , <u>Gravel well</u> (size) (material)			
(6) pump <u>3/4</u> , <u>14</u> (HP) (yield gpm)			
(type power)			
(7) electric log <u>Elect.</u> (yes or no)			
(organization running log)			
(8) how well bottom plugged <u>4" cap.</u>			
DRILLERS REMARKS:			


DEPT. OF NATURAL RESOURCES
 BUREAU OF LAND & WATER RESOURCES

OCT - 8 1980

RECEIVED

If well telescopes please sketch and show depths.

GROUND LEVEL

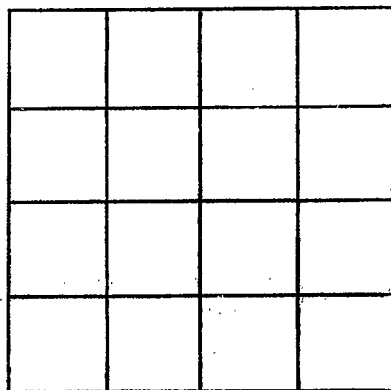

SECTION _____

Please indicate well location X.

ADDITIONAL INFORMATION

If more than one screen,
show locations of each on sketch.