

Marshall
K 2034
5/30/80

MISSISSIPPI
BOARD OF WATER COMMISSIONERS
416 North State Street
Jackson, Mississippi 39201

WATER WELL DRILLERS LOG

May 30 1980 R. L. Carpenter Marshall
date well completed firm name county well located

LANDOWNER: Raymond Mayfield
Holly Springs, Miss
RFD
(mailing address)

WELL LOCATION:
sec. 33 T. 3 N. R. 3 E
S W
3 miles West of H.S.
(distance) (direction) (nearest town)

WELL PURPOSE: None
(home, irrigation, municipal, industrial)

WELL COMPLETION DATA:
(1) diameter (inches) 4
(2) total depth (feet) 205
(3) static water level (feet) 147 below above top of ground.
(4) casing PVC, 195'
(material) (depth)
(size) if telescope see back.
(5) screen 18' 195'
(length) (depth to top)
4" PVC
(size) (material)
(6) pump 3/4 12
(HP) (yield gpm)
Elec.
(type power)
(7) electric log No.
(yes or no)
(organization running log)
(8) how well bottom plugged PVC Cap


description of formations encountered	from	to
Surface Soil	0	19
Med. Red Sand	19	40
White Coarse Sand	40	78
White Clay	78	110
White Fine Sand	110	180
White Coarse Sand	180	205

DRILLERS REMARKS:

DEPT. OF NATURAL RESOURCES
BUREAU OF LAND & WATER RESOURCES
MAY 18 1980
RECEIVED

If well telescopes please sketch and show depths.

GROUND LEVEL

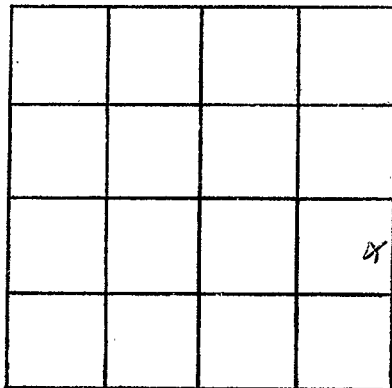

SECTION 33

Please indicate well location X.

ADDITIONAL INFORMATION

If more than one screen,
show locations of each on sketch.