

MARSHALL
K 2035
7/15/80

**MISSISSIPPI
 BOARD OF WATER COMMISSIONERS**
 416 North State Street
 Jackson, Mississippi 39201

WATER WELL DRILLERS LOG

July 15, 1980 date well completed R. L. Caserta firm name Marshall county well located

LANDOWNER: Mary Campbell
Holley Springs, Miss
R.F.D.
 (mailing address)

WELL LOCATION:
 sec. 34 T-3 N R-3 E
 S W
3 miles West of Holley Springs
 (distance) (direction) (nearest town)

WELL PURPOSE: None
 (home, irrigation, municipal, industrial)

- WELL COMPLETION DATA:**
- (1) diameter (inches) 4
 - (2) total depth (feet) 265
 - (3) static water level (feet) 200 below top of ground.
 - (4) casing Plastic, 25.5'
 (material) (depth)
 (size) If telescope see back.
 - (5) screen 10', 255'
 (length) (depth to top)
4", Plastic
 (size) (material)
 - (6) pump 3/4, 10
 (HP) (yield gpm)
Elec
 (type power)
 - (7) electric log no
 (yes or no)
 (organization running log)
 - (8) how well bottom plugged PVC cap

description of formations encountered	from	to
	<u>Surface soil</u>	<u>0</u>
<u>Med Red soil</u>	<u>25</u>	<u>60</u>
<u>Med White Sand</u>	<u>60</u>	<u>130</u>
<u>White Clay</u>	<u>130</u>	<u>165</u>
<u>White Fine Sand</u>	<u>165</u>	<u>190</u>
<u>White Clay</u>	<u>190</u>	<u>225</u>
<u>White Coarse Sand</u>	<u>225</u>	<u>265</u>


DRILLERS REMARKS:

DEPT. OF NATURAL RESOURCES
 BUREAU OF LAND & WATER RESOURCES

RECEIVED
 MAY 28 1981

If well telescopes please sketch and show depths.

GROUND LEVEL

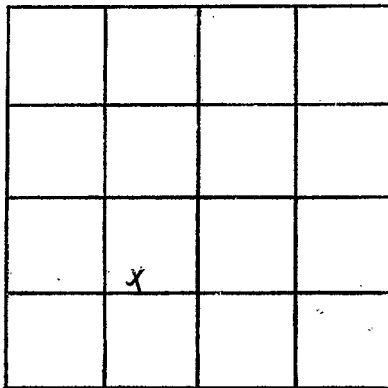

SECTION 34

Please indicate well location X.

ADDITIONAL INFORMATION

If more than one screen,
show locations of each on sketch.