

MISSISSIPPI DEPARTMENT OF NATURAL RESOURCES

Bureau of Land and Water Resources

Southport Mall

P.O. Box 10631


Jackson, Mississippi 39209

WATER WELL DRILLERS LOG

MARSHALL  
K 2036  
2/3/81


date well completed 1981 Deane Kent Benson firm name Marshall county well located

LANDOWNER:	description of formations encountered	from	to
<u>E &amp; E construction</u> <u>Nails Springs, Miss.</u> (mailing address)			
WELL LOCATION: sec. <u>19</u> T. <u>3</u> N. R. <u>3</u> E. <u>4</u> miles <u>South</u> of <u>Redbank</u> (distance) (direction) (nearest town)	<u>Sand</u>	<u>30</u>	<u>180</u>
WELL PURPOSE: <u>Dwellings</u> (home, irrigation, municipal, industrial)			
WELL COMPLETION DATA: (1) diameter (inches) <u>4"</u> (2) total depth (feet) <u>180 feet</u> (3) static water level (feet) <u>110</u> below above top of ground. (4) casing <u>PVC</u> , <u>130 feet</u> (material) (depth) (size) if telescope see back. (5) screen <u>7 ft.</u> , <u>173 feet</u> (length) (depth to top) <u>4"</u> , <u>gravel wall</u> (size) (material) (6) pump <u>3/4</u> , <u>14</u> (HP) (yield gpm) (type power) (7) electric log <u>Elect.</u> (yes or no) (organization running log) (8) how well bottom plugged <u>4" cap</u>			
DRILLERS REMARKS:			

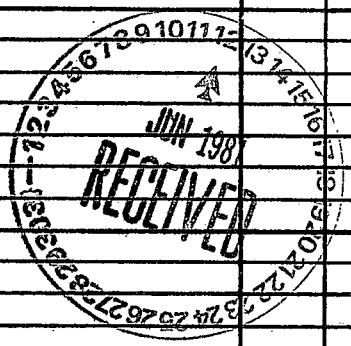

If well telescopes please sketch and show depths.

GROUND LEVEL

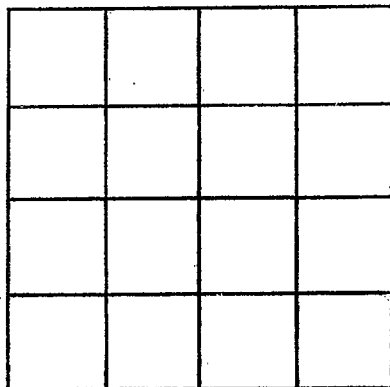

SECTION \_\_\_\_\_

Please indicate well location X.

ADDITIONAL INFORMATION

If more than one screen,  
show locations of each on sketch.