

**MISSISSIPPI  
BOARD OF WATER COMMISSIONERS**  
416 North State Street  
Jackson, Mississippi 39201

**WATER WELL DRILLERS LOG**

Marshall  
K 2039  
4/10/81  
4-10, 1981

Frost Well Supply

Marshall

date well completed

firm name

county well located

**LANDOWNER:**

Viola Watsen  
Holly Springs, Miss  
(mailing address)

**description of formations encountered**

from

to

clay	0	15
sand	15	80
clay	80	88
sand	88	145
clay	145	155
sand	155	170

**WELL LOCATION:**

sec. 1 T. 3 N. R. 3 E  
3 1/2 miles NW of Holly Springs  
(distance) (direction) (nearest town)

**WELL PURPOSE:**

(home, irrigation, municipal, industrial)

**WELL COMPLETION DATA:**

- (1) diameter (inches) 4"
- (2) total depth (feet) 170
- (3) static water level (feet) 130 below above top of ground.
- (4) casing PVC (material), (depth)  
4" (size) if telescope see back.
- (5) screen 10' (length), (depth to top)  
4" (size) (material)
- (6) pump 3/4 (HP), (yield gpm)  
Electric (type power)
- (7) electric log No (yes or no)  
(organization running log)
- (8) how well bottom plugged Cop


**DRILLERS REMARKS:**

DEPT. OF NATURAL RESOURCES  
BUREAU OF LAND & WATER RESOURCES

MAY 18 1981  
**RECEIVED**

If well telescopes please sketch and show depths.

GROUND LEVEL

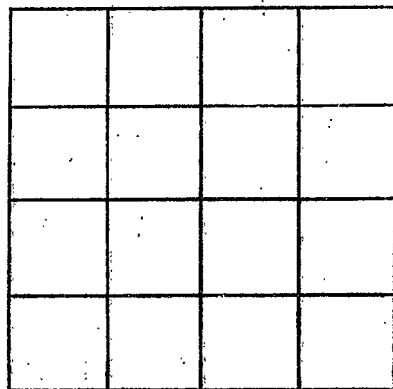

SECTION \_\_\_\_\_

Please indicate well location X.

ADDITIONAL INFORMATION

If more than one screen,  
show locations of each on sketch.