

MISSISSIPPI DEPARTMENT OF NATURAL RESOURCES

Bureau of Land and Water Resources

Southport Mall

P.O. Box 10631

Jackson, Mississippi 39209

WATER WELL DRILLERS LOG

MARSHALL
K 2040
4-29-81

4-29 1981 Hicks Well Co. Marshall
date well completed firm name county well located

LANDOWNER: Reba Crain
Hwy #78
Red Banks Ms.
(mailing address)

description of formations encountered	from	to
<u>Red Clay</u>	<u>0</u>	<u>20</u>
<u>Red sand</u>	<u>20</u>	<u>50</u>
<u>white sand</u>	<u>50</u>	<u>185</u>

WELL LOCATION:
sec. 17 T. 3 N. R. 3 E.
3 miles E of Red Banks
(distance) (direction) (nearest town)

WELL PURPOSE: home
(home, irrigation, municipal, industrial)

WELL COMPLETION DATA:

(1) diameter (inches) 4

(2) total depth (feet) 185

(3) static water level (feet) 100 below top of ground.

(4) casing PVC 185
(material) (depth)

 if telescope see back.
(size)

(5) screen 17' 17.3
(length) (depth to top)

4" gravel-type
(size) (material)


(6) pump 1/2 10
(HP) (yield gpm)

220V.
(type power)

(7) electric log No
(yes or no)

(organization running log)


(8) how well bottom plugged Cup

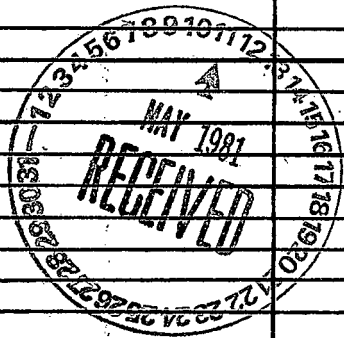

DRILLERS REMARKS:

If well telescopes please sketch and show depths.

GROUND LEVEL

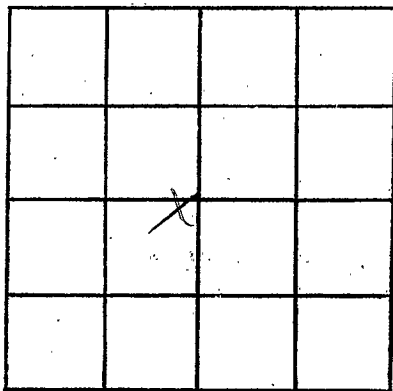

SECTION 17

Please indicate well location X.

ADDITIONAL INFORMATION

If more than one screen, show locations of each on sketch.