

MISSISSIPPI DEPARTMENT OF NATURAL RESOURCES

Bureau of Land and Water Resources

Southport Mall

P.O. Box 10631

Jackson, Mississippi 39209

WATER WELL DRILLERS LOG

MARSHALL
 K 2041
 9-16-81

9-16-81 date well completed
 Wilson Well Co firm name
 Marshall county well located

LANDOWNER:
 Claudette Iny
 Rt 4 Box 77D
 Holly Springs, Ms 38855
 (mailing address)

description of formations encountered	from	to
Red clay - Red sand	0	30
Red sand	30	90
White clay - white sand	90	105
White sand	105	155

WELL LOCATION:
 sec. 26 T-3 N R-3 E
 3 miles (distance) W of Holly Springs (nearest town)

WELL PURPOSE: Home
 (home, irrigation, municipal, industrial)

- WELL COMPLETION DATA:
- (1) diameter (inches) 4
 - (2) total depth (feet) 155
 - (3) static water level (feet) 140 below top of ground.
 - (4) casing Plastic (material), 4 (depth) (size) if telescope see back.
 - (5) screen 10 (length), 4 (depth to top) (size), Plastic (material)
 - (6) pump 3/4 (HP), 7 (yield gpm)
 electric (type power)
 - (7) electric log No (yes or no)

(organization running log)
 (8) how well bottom plugged Plastic Cap 4'

DRILLERS REMARKS:


DEPT. OF NATURAL RESOURCES
 BUREAU OF LAND & WATER RESOURCES

OCT 27 1981

RECEIVED

If well telescopes please sketch and show depths.

GROUND LEVEL

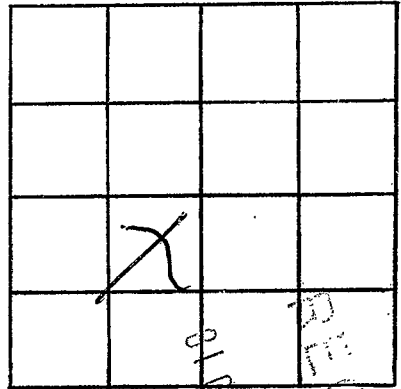

Please indicate well location X.

ADDITIONAL INFORMATION

If more than one screen, show locations of each on sketch.