

MISSISSIPPI DEPARTMENT OF NATURAL RESOURCES

Bureau of Land and Water Resources

Southport Mall

P.O. Box 10631

Jackson, Mississippi 39209

WATER WELL DRILLERS LOG

Marshall
K
2042

Marshall
county well located

5-5 1982 HICKS WELL COMPANY
date well completed

LANDOWNER: Roy Horn

description of formations encountered

Red Banks, Miss
(mailing address)

description of formations encountered	from	to
Red clay	0	10
Red Sand	10	95
White sand + clay	95	155
White Sand	155	185

WELL LOCATION:
sec. 17 T 3 N R 3 E
2 miles E of Redbank
(distance) (direction) (nearest town)

White sand + clay
White Sand

WELL PURPOSE: Home
(home, irrigation, municipal, industrial)

WELL COMPLETION DATA:

- (1) diameter (inches) 4
- (2) total depth (feet) 185
- (3) static water level (feet) 140 below top of ground.
- (4) casing PVC, 185 (material) (depth)
- (5) screen 10 (length) 175 (depth to top)
- (6) pump 1/2 (HP) 10 (yield gpm)
- (7) electric log No (yes or no)

(organization running log)

(8) how well bottom plugged CAP

DRILLERS REMARKS:


DEPT. OF NATURAL RESOURCES
BUREAU OF LAND & WATER RESOURCES

JUN 14 1982

RECEIVED

If well telescopes please sketch and show depths.

GROUND LEVEL

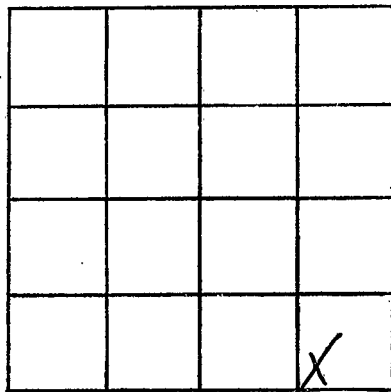

SECTION

17

Please indicate well location X.

ADDITIONAL INFORMATION

If more than one screen,
show locations of each on sketch.