

MISSISSIPPI DEPARTMENT OF NATURAL RESOURCES
Bureau of Land and Water Resources
 Southport Mall
 P.O. Box 10631
 Jackson, Mississippi 39209
WATER WELL DRILLERS LOG

Marshall
K
2044

5-31 19 82 Garner Houston Well Co. Marshall
 date well completed firm name county well located

LANDOWNER:
James L. Jennings
Rt 3 Box 495
Holly Springs, Miss. 38635
 (mailing address)

description of formations encountered	from	to
<u>Brown Clay</u>	<u>0</u>	<u>25</u>
<u>Red Sand</u>	<u>25</u>	<u>60</u>
<u>White Sand</u>	<u>60</u>	<u>125</u>
<u>White Clay & Sand mixed</u>	<u>125</u>	<u>135</u>
<u>White Sand</u>	<u>135</u>	<u>200</u>

WELL LOCATION:
 sec. 33 T. 3 N. R. 3 E.
3 miles W of Holly Springs
 (distance) (direction): (nearest town)

WELL PURPOSE:
 (home, irrigation, municipal, industrial)

- WELL COMPLETION DATA:**
- (1) diameter (inches) 4
 - (2) total depth (feet) 200'
 - (3) static water level (feet) 135 below above top of ground.
 - (4) casing Plastic, 190,
 (material) (depth)
4 if telescope see back.
 (size)
 - (5) screen 10', 190
 (length) (depth to top)
4, Plastic Slotted
 (size) (material)
 - (6) pump 1, 18
 (HP) (yield gpm)
Electric
 (type power)
 - (7) electric log (yes or no)
 (organization running log)
 - (8) how well bottom plugged 4"
cap

DRILLERS REMARKS:


MISSISSIPPI DEPARTMENT OF NATURAL RESOURCES
 BUREAU OF LAND & WATER RESOURCES

JUN 23 1982

RECEIVED

If well telescopes please sketch and show depths.

GROUND LEVEL

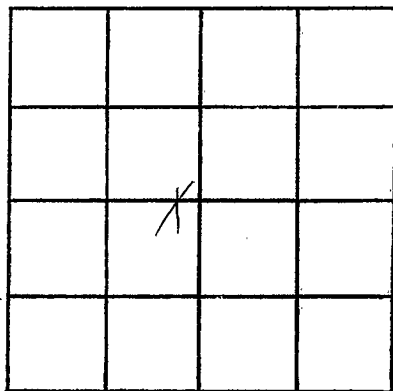

SECTION 33

Please indicate well location X.

ADDITIONAL INFORMATION

If more than one screen,
show locations of each on sketch.