

MISSISSIPPI DEPARTMENT OF NATURAL RESOURCES

Bureau of Land and Water Resources

Southport Mall

P.O. Box 10631

Jackson, Mississippi 39209

WATER WELL DRILLERS LOG

Marshall
K
2052

HICKS WELL CO.

Box 157
Senatobia, MS 38662

Marshall

8-19-82
date well completed

county well located

LANDOWNER: <u>Pauline Bridgeforth</u>	description of formations encountered	from	to
<u>Holly Springs, Miss</u> (mailing address) <u>38635</u>	<u>Red sand</u>	<u>0</u>	<u>20</u>
	<u>white sand</u>	<u>20</u>	<u>80</u>
WELL LOCATION: sec. <u>4</u> T. <u>3</u> N. R. <u>3</u> E <u>3</u> miles <u>NE</u> of <u>Red Bank</u> (distance) (direction) (nearest town)	<u>White sand & Clay</u>	<u>80</u>	<u>125</u>
	<u>White clay</u>	<u>125</u>	<u>155</u>
WELL PURPOSE: <u>Home</u> (home, irrigation, municipal, industrial)	<u>white sand</u>	<u>155</u>	<u>190</u>
WELL COMPLETION DATA: (1) diameter (inches) <u>4</u>			
(2) total depth (feet) <u>190</u>			
(3) static water level (feet) <u>100</u> <u>below</u> above top of ground.			
(4) casing <u>PVC</u> , <u>190</u> (material) (depth) <u>4"</u> (size) if telescope see back.			
(5) screen <u>10</u> , <u>185</u> (length) (depth to top) <u>2 1/2</u> , <u>PVC</u> (size) (material)			
(6) pump <u>1/2</u> , <u>10</u> (HP) (yield gpm) <u>220V</u> (type power)			
(7) electric log <u>No</u> (yes or no)			
(organization running log)			
(8) how well bottom plugged <u>Cap</u>			
DRILLERS REMARKS:			


DEPT. OF NATURAL RESOURCES
BUREAU OF LAND & WATER RESOURCES

AUG 27 1982

RECEIVED

If well telescopes please sketch and show depths.

GROUND LEVEL

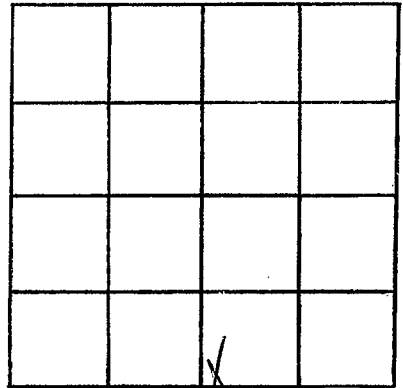

SECTION H

Please indicate well location X.

ADDITIONAL INFORMATION

If more than one screen,
show locations of each on sketch.