

MISSISSIPPI DEPARTMENT OF NATURAL RESOURCES

Bureau of Land and Water Resources

Southport Mall

P.O. Box 10631

Jackson, Mississippi 39209

WATER WELL DRILLERS LOG

Marshall
K
2053

10-10 1980 Bob Smith & Marshall county well located

LANDOWNER:

description of formations encountered

from

to

Freddie Malone
Holly Springs
 (mailing address)

| | | |
|------------|----|-----|
| top soil | 0 | 5 |
| red clay | 5 | 40 |
| gravel | 40 | 95 |
| white sand | 95 | 150 |

WELL LOCATION:

sec. 16-T-3 N R-3 E
 (S) (W)
5 miles W. of Holly Springs
 (distance) (direction) (nearest town)

WELL PURPOSE:

(home) irrigation, municipal, industrial

WELL COMPLETION DATA:

- (1) diameter (inches) 4"
- (2) total depth (feet) 150'
- (3) static water level (feet) 105' below above top of ground.
- (4) casing plastic 150'
 (material) (depth)
 _____ if telescope see back.
 (size)
- (5) screen 10' 140'
 (length) (depth to top)
4" plastic
 (size) (material)
- (6) pump 1/2 10
 (HP) (yield gpm)
elec
 (type power)
- (7) electric log (yes or no)
 (organization running log)
- (8) how well bottom plugged Cap

RECEIVED


OCT 13 1982

DEPT OF NATURAL RESOURCES
 BUREAU OF LAND & WATER RESOURCES

DRILLERS REMARKS:

If well telescopes please sketch and show depths.

GROUND LEVEL

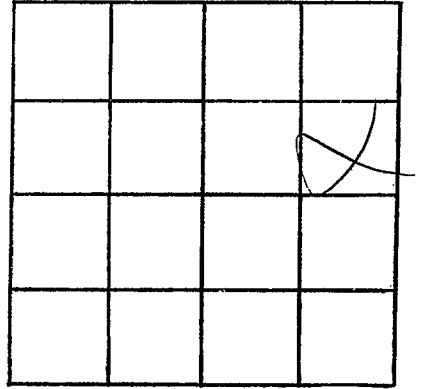

SECTION _____

Please indicate well location X.

ADDITIONAL INFORMATION

If more than one screen,
show locations of each on sketch.