

MISSISSIPPI DEPARTMENT OF NATURAL RESOURCES

Bureau of Land and Water Resources

Southport Mall

P.O. Box 10631

Jackson, Mississippi 39209

WATER WELL DRILLERS LOG

Marshall  
K 2054

11-2 1982 Deer Rent Bureau well Marshall  
date well completed firm name county well located


LANDOWNER:	description of formations encountered	from	to
<u>John Mc Clefuder</u>			
<u>Navy Springs, Miss.</u> (mailing address)	<u>Clay</u>	<u>0</u>	<u>20</u>
WELL LOCATION:	<u>Sand</u>	<u>30</u>	<u>140</u>
sec. <u>11</u> T. <u>3</u> N. R. <u>3</u> E.			
<u>5</u> miles <u>North</u> of <u>Holly Springs</u>			
(distance) (direction) (nearest town)			
WELL PURPOSE: <u>Residential</u> (home, irrigation, municipal, industrial)			
WELL COMPLETION DATA:			
(1) diameter (inches) <u>4"</u>			
(2) total depth (feet) <u>140 feet</u>			
(3) static water level (feet) <u>60</u> below above top of ground.			
(4) casing <u>PVC</u> , <u>140 feet</u> (material) (depth)			
<u>        </u> if telescope see back. (size)			
(5) screen <u>7' x 4"</u> , <u>133 feet</u> (length) (depth to top)			
<u>4"</u> , <u>gravel waf</u> (size) (material)			
(6) pump <u>3/4</u> <u>14</u> (HP) (yield gpm)			
<u>        </u> (type power)			
(7) electric log <u>relat.</u> (yes or no)			
<u>        </u> (organization running log)			
(8) how well bottom plugged <u>4' cap</u>			

DRILLERS REMARKS:

MISSISSIPPI DEPARTMENT OF NATURAL RESOURCES  
BUREAU OF LAND AND WATER RESOURCES  
RECEIVED  
JAN 12 1983

If well telescopes please  
sketch and show depths.

GROUND LEVEL

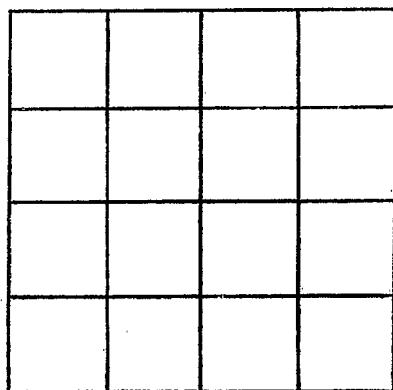

SECTION \_\_\_\_\_

Please indicate well location X.

ADDITIONAL INFORMATION

If more than one screen,  
show locations of each on sketch.