

MISSISSIPPI DEPARTMENT OF NATURAL RESOURCES
 Bureau of Land and Water Resources
 Southport Mall
 P.O. Box 10631
 Jackson, Mississippi 39209
WATER WELL DRILLERS LOG

Marshall
K2058

3-30-84 date well completed Wilson Well Co. Inc. firm name Marshall county well located

LANDOWNER: Robert Evans
Rt 2 Box 352
Holly Springs, Miss.
 (mailing address)

WELL LOCATION:
 sec 26 T. 3 N. R. 3 E.
3 miles NW of Holly Springs
 (distance) (direction) (nearest town)

description of formations encountered	from to	
	from	to
Brown Red Clay	0	15
Red Sand	15	45
White Clay	45	47
White Sand	47	90
White Clay	90	96
White Sand	96	150

WELL PURPOSE: Home
 (home, irrigation, municipal, industrial)

- WELL COMPLETION DATA:
- diameter (inches) 4
 - total depth (feet) 147
 - static water level (feet) 106 below top of ground.
 - casing Plastic, 120,
 (material) (depth)
4 If telescope see back.
 (size)
 - screen 10,
 (length) (depth to top)
4, Plastic
 (size) (material)
 - pump 3/4, 8
 (HP) (yield gpm)
Flec.
 (type power)
 - electric log No
 (yes or no)
 (organization running log)
 - how well bottom plugged 4 = PVC CAP

DRILLERS REMARKS:


DEPT. OF NATURAL RESOURCES
 BUREAU OF LAND & WATER RESOURCES

MAY 31 1984

RECEIVED

If well telescopes please sketch and show depths.

GROUND LEVEL

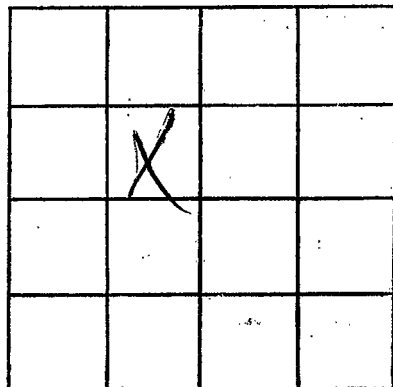

SECTION 26

Please indicate well location X.

ADDITIONAL INFORMATION

If more than one screen,
show locations of each on sketch.