

MISSISSIPPI DEPARTMENT OF NATURAL RESOURCES

Bureau of Land and Water Resources

Southport Mall

P.O. Box 10631

Jackson, Mississippi 39209

WATER WELL DRILLERS LOG

MARSHALL
K 2059

6-20 1985 date well completed Larry Carpenter Well Co. firm name Marshall county well located

LANDOWNER: Sadie Manuel
Red Banks, ms.
RFD
 (mailing address)

description of formations encountered	from	to
Surface Soil	0	2.5
Med & Fine Red Sand	2.5	4.8
Fine white sand	4.8	8.0
White Clay & Fine White Sand	8.0	11.5
White Clay	11.5	13.2
White coarse sand	13.2	16.5

WELL LOCATION:
 sec. 5 T. 3 N. R. 3 E
S W
2 1/2 miles NE of Red Banks
 (distance) (direction) (nearest town)

WELL PURPOSE: Home
 (home, irrigation, municipal, industrial)


WELL COMPLETION DATA:

- (1) diameter (inches) 4
- (2) total depth (feet) 16.5
- (3) static water level (feet) 10.5 below top of ground.
- (4) casing PVC, 15.5'
 (material) (depth)
 (size) if telescope see back.
- (5) screen 18', 15.5'
 (length) (depth to top)
4 in, PVC
 (size) (material)
- (6) pump 3/4 12
 (HP) (yield gpm)
2hp
 (type power)
- (7) electric log No
 (yes or no)

(organization running log)

(8) how well bottom plugged PVC cap

DRILLERS REMARKS:

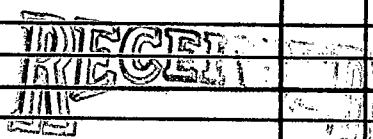


JUL 23 1985

Department of Natural Resources
 Bureau of Land & Water Resources

If well telescopes please sketch and show depths.

GROUND LEVEL

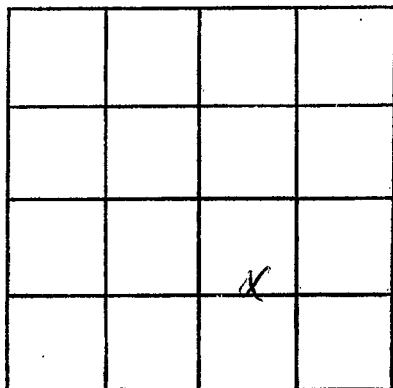

SECTION 5

Please indicate well location X.

ADDITIONAL INFORMATION

If more than one screen, show locations of each on sketch.