

MISSISSIPPI DEPARTMENT OF NATURAL RESOURCES

Bureau of Land and Water Resources

Southport Mall

P.O. Box 10631

Jackson, Mississippi 39209

WATER WELL DRILLERS LOG

MARSHALL
 K 2060

7-29 19 ~~85~~ *86* Larry Capeta Well Co firm name Marshall county well located

LANDOWNER: Tramie Kersh
Red Bank, ms
RFD
 (mailing address)

WELL LOCATION:
 sec. 5 T 3 N R 3 E
2 1/2 miles NE of Red Bank
 (distance) (direction) (nearest town)

WELL PURPOSE: Home
 (home, irrigation, municipal, industrial)

WELL COMPLETION DATA:

- (1) diameter (inches) 4
- (2) total depth (feet) 185
- (3) static water level (feet) 100 below above top of ground.
- (4) casing PVC (material), 175' (depth)
- (size) if telescope see back.
- (5) screen 10' (length), 175' (depth to top)
- 1/2" (size), PVC (material)
- (6) pump 3/4 (HP), 17 (yield gpm)
- Elec. (type power)
- (7) electric log no (yes or no)
- (organization running log)
- (8) how well bottom plugged PVC cap

description of formations encountered	from	to
<u>Surface Soil</u>	<u>0</u>	<u>25</u>
<u>Med. & Fine Red Sand</u>	<u>25</u>	<u>50</u>
<u>Fine White Sand</u>	<u>50</u>	<u>85</u>
<u>White Clay</u>	<u>85</u>	<u>120</u>
<u>White Coarse Sand</u>	<u>120</u>	<u>185</u>


MISSISSIPPI DEPARTMENT OF NATURAL RESOURCES
BUREAU OF LAND & WATER RESOURCES
 JUL 23 1986

DRILLERS REMARKS:

Department of Natural Resources
 Bureau of Land & Water Resources

If well telescopes please sketch and show depths.

GROUND LEVEL

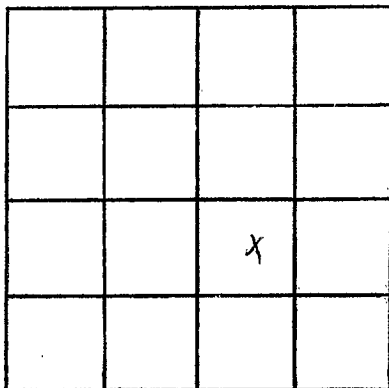

SECTION 5

Please indicate well location X.

ADDITIONAL INFORMATION

If more than one screen, show locations of each on sketch.