

MARSHALL  
K 2061

MISSISSIPPI DEPARTMENT OF NATURAL RESOURCES  
 Bureau of Land and Water Resources  
 Southport Mall  
 P.O. Box 10631  
 Jackson, Mississippi 39209  
**WATER WELL DRILLERS LOG**

8-1 1985 Lamy Copesta Well Co. Marshall  
 date well completed firm name county well located

LANDOWNER: Philip Byrd  
Holly Springs, ms  
RFD  
 (mailing address)


description of formations encountered	from	to
<u>Surface Soil</u>	<u>0</u>	<u>2.0</u>
<u>Med. Red Sand</u>	<u>2.0</u>	<u>4.2</u>
<u>Med. white Sand</u>	<u>4.2</u>	<u>7.5</u>
<u>white clay</u>	<u>7.5</u>	<u>10.3</u>
<u>Med. white Sand</u>	<u>10.3</u>	<u>14.0</u>
<u>white coarse Sand</u>	<u>14.0</u>	<u>17.9</u>

WELL LOCATION:  
 sec 21 T 3 N R 3 E  
3 miles East of Red Bank  
 (distance) (direction) (nearest town)

WELL PURPOSE: Home  
 (home, irrigation, municipal, industrial)

WELL COMPLETION DATA:

- (1) diameter (inches) 4
- (2) total depth (feet) 17.9
- (3) static water level (feet) 1.6 below above top of ground.
- (4) casing PVC, 168'  
 (material) (depth)  
 (size) If telescope see back.
- (5) screen 10', 168'  
 (length) (depth to top)  
1/2", PVC  
 (size) (material)
- (6) pump 1/2, 10  
 (HP) (yield gpm)  
Elco  
 (type power)
- (7) electric log No  
 (yes or no)  
 (organization running log)
- (8) how well bottom plugged PVC Caps

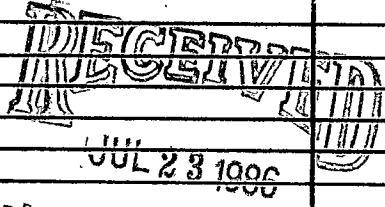


Department of Natural Resources  
 Bureau of Land & Water Resources

DRILLERS REMARKS:

If well telescopes please sketch and show depths.

GROUND LEVEL

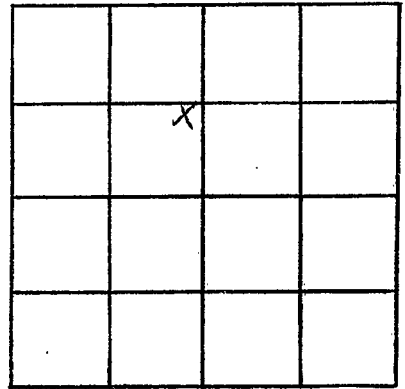

SECTION 21

Please indicate well location X.

ADDITIONAL INFORMATION

If more than one screen, show locations of each on sketch.