

MISSISSIPPI DEPARTMENT OF NATURAL RESOURCES

Bureau of Land and Water Resources

Southport Mall

P.O. Box 10631

Jackson, Mississippi 39209

WATER WELL DRILLERS LOG

MARSHALL
K 2062

8-9 1985 Larry Carpenter Well Co. Marshall
date well completed firm name county well located

LANDOWNER: Carl Camp

Holly Springs, Ms.
RFD

(mailing address)

description of formations encountered

from

to

Surface Soil	0	2.5
Med. Red Soil	25	38
Med. White Sand	38	60
White Fine Sand	60	120
White Coarse Sand	120	147

WELL LOCATION:

sec. 2 T. 3 N. R. 3 E.
S. W.
5 miles North of H.S.
(distance) (direction) (nearest town)


WELL PURPOSE: Home
(home, irrigation, municipal, industrial)

WELL COMPLETION DATA:

- (1) diameter (inches) 4
- (2) total depth (feet) 147
- (3) static water level (feet) 40 below top of ground.
- (4) casing PVC, 137' (material) (depth)
(size) if telescope see back.
- (5) screen 10', 137' (length) (depth to top)
4 in., PVC (size) (material)
- (6) pump 3/4, 12 (HP) (yield gpm)
Electric (type power)
- (7) electric log No. (yes or no)

(organization running log)

(8) how well bottom plugged PVC Caps

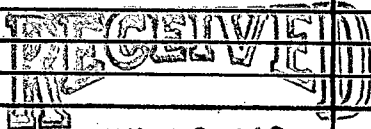

JUL 23 1986

Department of Natural Resources
Bureau of Land & Water Resources

DRILLERS REMARKS:

If well telescopes please sketch and show depths.

GROUND LEVEL

X			

SECTION 2

Please indicate well location X.

ADDITIONAL INFORMATION

If more than one screen, show locations of each on sketch.