

MISSISSIPPI DEPARTMENT OF NATURAL RESOURCES

Bureau of Land and Water Resources

Southport Mall

P.O. Box 10631

Jackson, Mississippi 39209

WATER WELL DRILLERS LOG

Marshall
K 2064

11-5 1985 Larry Carpenter Wells Marshall
 date well completed firm name county well located

LANDOWNER: L.R. Dullidge
Holly Springs
Ms. RFD
 (mailing address)


WELL LOCATION:
 sec. 5 T. 3 N R. 3 E
S W
2 1/2 miles NE of Red Bank
 (distance) (direction) (nearest town)

WELL PURPOSE: None
 (home, irrigation, municipal, industrial)

WELL COMPLETION DATA:

- (1) diameter (inches) 4
- (2) total depth (feet) 150
- (3) static water level (feet) 95 below above top of ground.
- (4) casing PVC 140'
 (material) (depth)
 (size) If telescope see back.
- (5) screen 10' 140'
 (length) (depth to top)
4" PVC
 (size) (material)
- (6) pump 1/2 10
 (HP) (yield gpm)
Elber
 (type power)
- (7) electric log
 (yes or no)
 (organization running log)
- (8) how well bottom plugged PVC cap

description of formations encountered	from	to
<u>Surface Soil</u>	<u>0</u>	<u>20</u>
<u>Med. Red Sand</u>	<u>20</u>	<u>55</u>
<u>Fine White Sand</u>	<u>55</u>	<u>90</u>
<u>White Clay</u>	<u>90</u>	<u>110</u>
<u>White Coarse Sand</u>	<u>110</u>	<u>150</u>

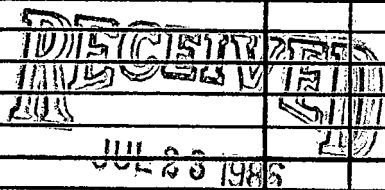


Department of Natural Resources
 Bureau of Land & Water Resources

DRILLERS REMARKS:

If well telescopes please sketch and show depths.

GROUND LEVEL

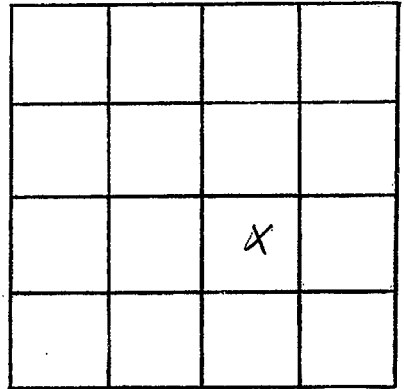

SECTION 5

Please indicate well location X.

ADDITIONAL INFORMATION

If more than one screen, show locations of each on sketch.