

MISSISSIPPI DEPARTMENT OF NATURAL RESOURCES

Bureau of Land and Water Resources

Southport Mall

P.O. Box 10631

Jackson, Mississippi 39209

WATER WELL DRILLERS LOG

*Marshall*  
*K 2065*

1-9 1986 Larry Carpenter Wells, Marshall  
date well completed firm name county well located

LANDOWNER: Lynn Stephens  
Holly Springs  
Ms. RFD  
(mailing address)

description of formations encountered	from	to
<u>Surface Soil</u>	<u>0</u>	<u>20</u>
<u>Coarse Red Sand</u>	<u>20</u>	<u>42</u>
<u>Med White Sand</u>	<u>42</u>	<u>80</u>
<u>White Clay</u>	<u>80</u>	<u>105</u>
<u>White Fine Sand</u>	<u>105</u>	<u>120</u>
<u>White coarse sand</u>	<u>120</u>	<u>165</u>

WELL LOCATION:

sec. 17 T 3 N R 3 E  
2 miles East of Red Bank  
(distance) (direction) (nearest town)

WELL PURPOSE: Home  
(home, irrigation, municipal, industrial)

WELL COMPLETION DATA:


- (1) diameter (inches) 4
- (2) total depth (feet) 165
- (3) static water level (feet) 115 below above top of ground.
- (4) casing PVC 155'  
(material) (depth)  
(size) if telescope see back.
- (5) screen 10' 155'  
(length) (depth to top)  
4" PVC  
(size) (material)
- (6) pump 3/4 12  
(HP) (yield gpm)  
Electric  
(type power)
- (7) electric log no  
(yes or no)  
(organization running log)
- (8) how well bottom plugged PVC Cap

DRILLERS REMARKS:

DISCOVERED  
WATER  
JUL 21 1986  
Department of Natural Resources  
Bureau of Land and Water Resources

If well telescopes please sketch and show depths.

GROUND LEVEL

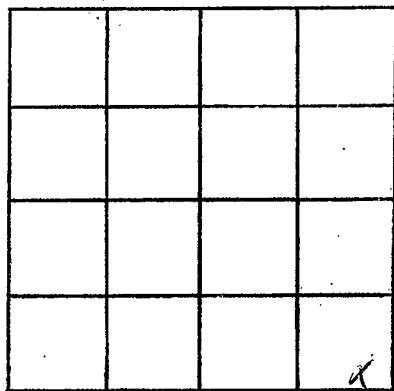

SECTION 17

Please indicate well location X.

ADDITIONAL INFORMATION

If more than one screen,  
show locations of each on sketch.