

MISSISSIPPI DEPARTMENT OF NATURAL RESOURCES
Bureau of Land and Water Resources
 Southport Mall
 P.O. Box 10631
 Jackson, Mississippi 39209
WATER WELL DRILLERS LOG

Marshall
K2066

3-19 1986 Larry Carpenter W. B. Marshall
 date well completed firm name county well located


LANDOWNER: Fred Cumington
Red Banks, Ms.
RFD
 (mailing address)

description of formations encountered	from	to
<u>Surface Soil</u>	<u>0</u>	<u>22</u>
<u>med. Red Sand</u>	<u>22</u>	<u>48</u>
<u>med. White Sand</u>	<u>48</u>	<u>80</u>
<u>White Clay & Fine Sand</u>	<u>80</u>	<u>115</u>
<u>white coarse sand</u>	<u>115</u>	<u>135</u>

WELL LOCATION:
 sec. 5 T. 3 N R. 3 E
2 1/2 miles NE of Red Banks
 (distance) (direction) (nearest town)

WELL PURPOSE: Home
 (home, irrigation, municipal, industrial)

- WELL COMPLETION DATA:
- (1) diameter (inches) 4
 - (2) total depth (feet) 135
 - (3) static water level (feet) 92 below top of ground.
 - (4) casing PVC, 125'
 (material) (depth)
 (size) If telescope see back.
 - (5) screen 10', 125'
 (length) (depth to top)
4", PVC
 (size) (material)
 - (6) pump 3/4, 12
 (HP) (yield gpm)
Elec
 (type power)
 - (7) electric log no
 (yes or no)
 (organization running log)
 - (8) how well bottom plugged PVC cap

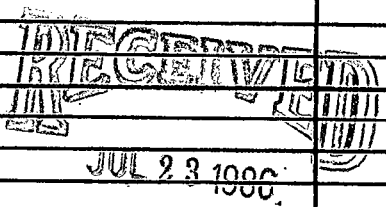


Department of Natural Resources
 Bureau of Land & Water Resources

DRILLERS REMARKS:

If well telescopes please sketch and show depths.

GROUND LEVEL

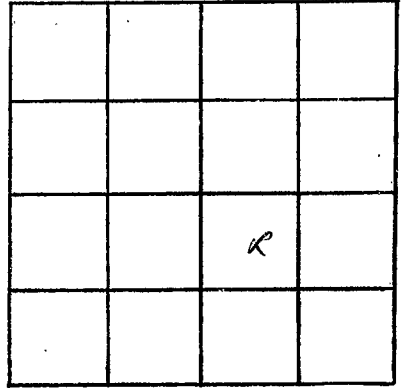

SECTION 5

Please indicate well location X.

ADDITIONAL INFORMATION

If more than one screen,
show locations of each on sketch.