

MISSISSIPPI DEPARTMENT OF NATURAL RESOURCES

Bureau of Land and Water Resources

COUNTY WELL LOCATED <i>Marshall</i>	
WELL NUMBER <i>K 2073</i>	CODED
DATE WELL COMPLETED <i>2-27-90</i>	

PERMIT NUMBER
NAME OF DRILLING COMPANY HICKS WELL CO. RT. 1 BOX 157 SENATOBIA, MS 38668

P.O. Box 10631
Jackson, Mississippi 39209
WATER WELL DRILLERS LOG

NAME & MAILING ADDRESS OF LANDOWNER <i>EdNEST SPOON</i>		
<i>RT. 3</i>		
<i>Holly Springs</i>		
WELL LOCATION: SEC	TOWNSHIP	RANGE
<i>32</i>	<i>3</i>	<i>3</i>
DISTANCE	DIRECTION	NEAREST TOWN
<i>5</i> Miles	<i>W</i>	of <i>H.S.</i>
OTHER LANDMARK <i>on Hernando Rd.</i>		
WELL PURPOSE: <input checked="" type="checkbox"/> Home Irrigation, <input type="checkbox"/> Municipal, <input type="checkbox"/> Industrial, <input type="checkbox"/> Fish Pond, etc.		

PUMP DATA		
PUMP TYPE (Circle One): <input checked="" type="checkbox"/> Submersible, <input type="checkbox"/> Turbine, <input type="checkbox"/> Jet <input type="checkbox"/> Flowing Well, Other (Describe) _____		
POWER TYPE (Circle One): <input checked="" type="checkbox"/> Electric, <input type="checkbox"/> Tractor, <input type="checkbox"/> Diesel, <input type="checkbox"/> Gasoline, <input type="checkbox"/> Butane, Other (Describe) _____ H/P <i>3/4</i>		
Pump Capacity (GPM) <i>10</i>	No. of Stages <i>12</i>	Setting Depth <i>160</i> FT.
PUMP TEST		
Well yielded <i>10</i> GPM with a drawdown of _____ ft. after _____ hours of pumping		


WELL DATA		
Well Depth <i>200</i>	Casing Diameter (In.) <i>4"</i>	Casing Length (Ft.) <i>190</i>
Type of Casing <i>PVC</i>	Hole Depth <i>200</i>	Depth to Static Water Level <i>140</i>
TYPE OF COMPLETION: (Circle One or More): <input checked="" type="checkbox"/> Gravel Packed, <input type="checkbox"/> Underreamed, <input type="checkbox"/> Telescoped, <input type="checkbox"/> Natural Development, <input type="checkbox"/> Open Hole, <input type="checkbox"/> Other (Describe) _____		
Top of Lap Pipe or Reduction in Casing FEET <input type="checkbox"/> IF TELESCOPED OR MORE THAN ONE SCREEN: USE BACK PAGE		

LOG DATA	
TYPE OF LOG RUN (Circle One): <input type="checkbox"/> No Log Run, <input type="checkbox"/> Electric, <input type="checkbox"/> Gamma Ray, <input type="checkbox"/> Density, <input type="checkbox"/> Sonic, <input type="checkbox"/> Neutron, Other (Describe) _____	
Name of Organization Running Log	

SCREEN DATA		
Diameter - Inches <i>4"</i>	Length - Feet <i>10'</i>	Slot Size - Inches <i>013</i>
Screen Type <i>PVC</i>	Depth to Bottom - Feet <i>10</i>	


GEOLOGIC DATA (Office Use Only)			
Surface Elev.	Geologic Unit	Unit Thickness	Depth to Top
Subs. SWL	Date	Analysis	Aquifer Test
Driller's Remarks			

DESCRIPTION OF FORMATIONS ENCOUNTERED	FROM	TO
<i>R.C.</i>	<i>0</i>	<i>30</i>
<i>R.C & SAND</i>	<i>30</i>	<i>90</i>
<i>W SAND & C</i>	<i>90</i>	<i>140</i>
<i>W SAND</i>	<i>140</i>	<i>200</i>

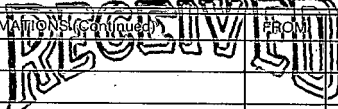 MAR 26 1990 Department of Natural Resources Bureau of Land & Water Resources	FORMATIONS (continued) FROM TO
IF MORE SPACE IS NEEDED, USE BACK	

If well telescopes please
sketch and show depths.

GROUND LEVEL

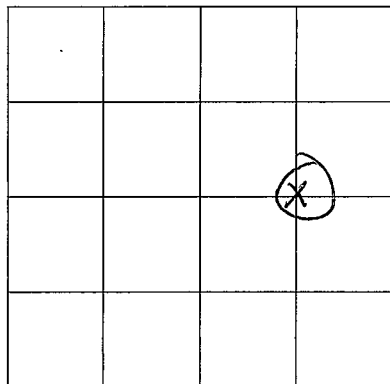

SECTION _____

Please indicate well location X.

ADDITIONAL INFORMATION

If more than one screen,
show location of each on sketch.