

MISSISSIPPI DEPARTMENT OF NATURAL RESOURCES

Bureau of Land and Water Resources

COUNTY WELL LOCATED MARSHAL	
WELL NUMBER K 2075	CODED
DATE WELL COMPLETED 5-8-90	

PERMIT NUMBER
NAME OF DRILLING FIRM HICKS WELL CO.
RT. 1 BOX 157
SENATOBIA, MS 38668

P.O. Box 10631
Jackson, Mississippi 39209
WATER WELL DRILLERS LOG

NAME & MAILING ADDRESS OF LANDOWNER Henderson Thig Pen			
RT. 4 BOX 117			
HOLLY SPRINGS, MS			
WELL LOCATION:	SEC	TOWNSHIP	RANGE
	8	3	N 30 E
DISTANCE	DIRECTION	NEAREST TOWN	
3 Miles	NE	Red Bay	
OTHER LANDMARK Fox Fire Rd			
WELL PURPOSE <input checked="" type="radio"/> Home Irrigation, Municipal, Industrial, Fish Pond, etc.			

PUMP DATA			
PUMP TYPE (Circle One): <input checked="" type="radio"/> Submersible Turbine, Jet, Flowing Well, Other (Describe) _____			
POWER TYPE (Circle One): <input checked="" type="radio"/> Electric, Tractor, Diesel, Gasoline, Butane, Other (Describe) _____ H/P 1/2			
Pump Capacity (GPM)	No. of Stages	Setting Depth	
10	9	100 FT.	
PUMP TEST			
Well yielded 10 GPM with a drawdown of _____ ft. after _____ hours of pumping			

WELL DATA			
Well Depth 140	Casing Diameter (In.) 4'	Casing Length (Ft.) 130	
Type of Casing PVC	Hole Depth 140	Depth to Static Water Level 80	
TYPE OF COMPLETION: (Circle One or More): <input checked="" type="radio"/> Gravel Pack, Underreamed, Telescoped, Natural Development, Open Hole, Other (Describe) _____			
Top of Lap Pipe or Reduction in Casing FEET IF TELESCOPED OR MORE THAN ONE SCREEN: USE BACK PAGE			

LOG DATA	
TYPE OF LOG RUN (Circle One): No Log Run, Electric, Gamma Ray, Density, Sonic, Neutron, Other (Describe) _____	
Name of Organization Running Log	

SCREEN DATA			
Diameter - Inches 4"	Length - Feet 10'	Slot Size - Inches 0/3	
Screen Type PVC		Depth to Bottom - Feet 10'	


GEOLOGIC DATA (Office Use Only)			
Surface Elev.	Geologic Unit	Unit Thickness	Depth to Top
Subs. SWL	Date	Analysis	Aquifer Test
Driller's Remarks			

DESCRIPTION OF FORMATIONS ENCOUNTERED	FROM	TO	FORMATIONS (Continued)	FROM	TO
RC	0	20	RECEIVED JUN 07 1990 Department of Natural Resources Bureau of Land & Water Resources		
RC & S	20	80			
W.S.	80	140			

IF MORE SPACE IS NEEDED, USE BACK

If well telescopes please
sketch and show depths.

GROUND LEVEL

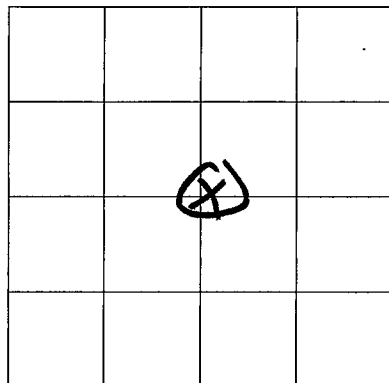

SECTION _____

Please indicate well location X.

ADDITIONAL INFORMATION

Multiple horizontal lines for writing additional information.

If more than one screen,
show location of each on sketch.