

**MISSISSIPPI DEPARTMENT OF ENVIRONMENTAL QUALITY**  
Bureau of Land and Water Resources

P. O. Box 10631  
Jackson, MS 39289-0631  
**WATER WELL DRILLERS LOG**

COUNTY WELL LOCATED <b>MARSHALL</b>	
WELL NUMBER <b>R 2084</b>	CODED
DATE WELL COMPLETED <b>5-18-93</b>	

PERMIT NUMBER <b>HICKS WELL CO.</b>
NAME OF DRILLING FIRM <b>RT 1 BOX 157</b>
<b>SENATOBIA, MS 38668</b>

NAME & MAILING ADDRESS OF LANDOWNER <b>Davei Pyle</b>			
<b>RT 3</b>			
<b>Holly Springs MS</b>			
WELL LOCATION:	SEC	TOWNSHIP	RANGE
	<b>29</b>	<b>3</b>	<b>3</b>
		<b>N</b>	<b>E</b>
		<b>S</b>	<b>W</b>
DISTANCE	DIRECTION	NEAREST TOWN	
<b>6</b> Miles	<b>West</b>	of <b>Holly Springs</b>	
OTHER LANDMARK			
WELL PURPOSE <input checked="" type="checkbox"/> Home Irrigation, <input type="checkbox"/> Municipal, <input type="checkbox"/> Industrial, <input type="checkbox"/> Fish Pond, etc.			

<b>PUMP DATA</b>			
PUMP TYPE (Circle One): <input checked="" type="checkbox"/> Submersible, <input type="checkbox"/> Turbine, <input type="checkbox"/> Jet <input type="checkbox"/> Flowing Well, Other (Describe) _____			
POWER TYPE (Circle One): <input checked="" type="checkbox"/> Electric, <input type="checkbox"/> Tractor, <input type="checkbox"/> Diesel, <input type="checkbox"/> Gasoline, <input type="checkbox"/> Butane, Other (Describe) _____ H/P <b>1/2</b>			
Pump Capacity (GPM)	No. of Stages	Setting Depth	
<b>10</b>	<b>12</b>	<b>160</b> FT.	
PUMP TEST			
Well yielded _____ GPM with a drawdown of _____ ft. after _____ hours of pumping			

<b>WELL DATA</b>		
Well Depth <b>200</b>	Casing Diameter (In.) <b>4"</b>	Casing Length (Ft.) <b>190</b>
Type of Casing <b>PVC</b>	Hole Depth <b>200</b>	Depth to Static Water Level <b>140'</b>
TYPE OF COMPLETION: (Circle One or More): <input checked="" type="checkbox"/> Gravel Packed, <input type="checkbox"/> Underreamed, <input type="checkbox"/> Telescoped, <input type="checkbox"/> Natural Development, <input type="checkbox"/> Open Hole, <input type="checkbox"/> Other (Describe) _____		
Top of Lap Pipe or Reduction in Casing		
FEET: <input type="checkbox"/> IF TELESCOPED OR MORE THAN ONE SCREEN: USE BACK PAGE		

<b>LOG DATA</b>	
TYPE OF LOG RUN (Circle One): <input type="checkbox"/> No Log Run, <input type="checkbox"/> Electric, <input type="checkbox"/> Gamma Ray, <input type="checkbox"/> Density, <input type="checkbox"/> Sonic, <input type="checkbox"/> Neutron, Other (Describe) _____	
Name of Organization Running Log	

<b>SCREEN DATA</b>		
Diameter - Inches <b>4"</b>	Length - Feet <b>10'</b>	Slot Size - Inches <b>013</b>
Screen Type <b>PVC</b>	Depth to Bottom - Feet <b>10'</b>	


<b>GEOLOGIC DATA (Office Use Only)</b>			
Surface Elev.	Geologic Unit	Unit Thickness	Depth to Top
Subs. SWL	Date	Analysis	Aquifer Test

Driller's Remarks

DESCRIPTION OF FORMATIONS ENCOUNTERED	FROM	TO	FORMATIONS (Continued)	FROM	TO
Red Sand	0	40	<b>RECEIVED</b>		
Clay	40	140			
Sand & Clay	140	160			
White Sand	160	200			
			<b>MAY 25 1993</b>		
			Dept. of Environmental Quality Office of Land & Water Resources		
			IF MORE SPACE IS NEEDED, USE BACK		

If well telescopes please sketch and show depths.

GROUND LEVEL

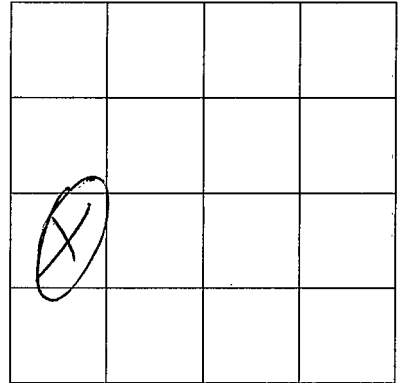

SECTION \_\_\_\_\_

Please indicate well location X.

ADDITIONAL INFORMATION

If more than one screen,  
show location of each on sketch.