

MISSISSIPPI DEPARTMENT OF ENVIRONMENTAL QUALITY

COUNTY WELL LOCATED
MARSHALL

WELL NUMBER R 2085 CODED

DATE WELL COMPLETED
4-27-94

PERMIT NUMBER **HICKS WELL CO.**

NAME OF DRILLING CONTRACTOR **RTM BOX 157**

SENATOBIA, MS - 38668

Office of Land and Water Resources

P. O. Box 10631
Jackson, MS 39289-0631
WATER WELL DRILLERS LOG

NAME & MAILING ADDRESS OF LANDOWNER
Yvonne Bownes

123 West Wilson Ave

Holly Springs MS

WELL LOCATION: SEC 35 TOWNSHIP 3 RANGE 3

DISTANCE 2 Miles DIRECTION West of NEAREST TOWN Holly Springs

OTHER LANDMARK

WELL PURPOSE Home Irrigation, Municipal, Industrial, Fish Pond, etc.

PUMP DATA

PUMP TYPE (Circle One):
 Submersible Turbine, Jet, Flowing Well,
Other (Describe) _____

POWER TYPE (Circle One):
 Electric Tractor, Diesel, Gasoline, Butane,
Other (Describe) _____ H/P 1/2

Pump Capacity (GPM) <u>10</u>	No. of Stages	Setting Depth <u>220</u> FT.
----------------------------------	---------------	---------------------------------

PUMP TEST

Well yielded _____ GPM with
a drawdown of _____ ft.
after _____ hours of pumping

WELL DATA

Well Depth <u>255</u>	Casing Diameter (In.) <u>4"</u>	Casing Length (Ft.) <u>245</u>
Type of Casing <u>Pvc</u>	Hole Depth <u>255</u>	Depth to Static Water Level <u>180'</u>

TYPE OF COMPLETION: (Circle One or More):
 Gravel Packed, Underreamed, Telescoped,
 Natural Development, Open Hole, Other
(Describe) _____

WELL GROUTED TO A DEPTH OF 10 FEET
Type Grout (circle one): Cement, Bentonite, or Mix

LOG DATA

TYPE OF LOG RUN (Circle One):
 No Log Run,
 Electric, Gamma Ray, Density, Sonic, Neutron,
Other (Describe) _____

Name of Organization Running Log

SCREEN DATA

Diameter - Inches <u>4"</u>	Length - Feet <u>10'</u>	Slot Size - Inches <u>.013</u>
Screen Type <u>Pvc</u>	Depth to Bottom - Feet <u>255</u>	

GEOLOGIC DATA (Office Use Only)

Surface Elev.	Geologic Unit	Unit Thickness	Depth to Top
Subs. SWL	Date	Analysis	Aquifer Test

Driller's Remarks

Top of Lap Pipe or Reduction in Casing

FEET IF TELESKOPED OR MORE THAN ONE SCREEN: USE BACK PAGE

DESCRIPTION OF FORMATIONS ENCOUNTERED	FROM	TO	FORMATIONS (Continued)	
			FROM	TO
<u>Red Sand</u>	<u>0</u>	<u>40</u>		
<u>SAND & CLAY</u>	<u>40</u>	<u>180</u>		
<u>White Sand</u>	<u>180</u>	<u>255</u>		

RECEIVED


AUG 09 1994

Dept. of Environmental Quality
Office of Land & Water Resources

IF MORE SPACE IS NEEDED, USE BACK

If well telescopes please sketch and show depths.

GROUND LEVEL

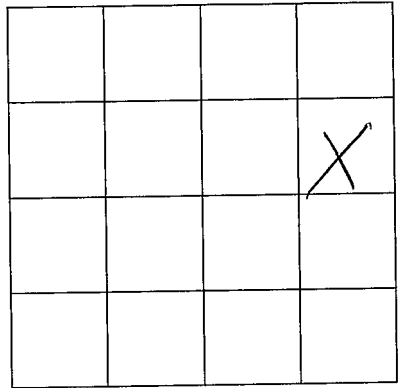

SECTION 35

Please indicate well location X.

ADDITIONAL INFORMATION

If more than one screen,
show location of each on sketch.