

**MISSISSIPPI DEPARTMENT OF ENVIRONMENTAL QUALITY**

Office of Land and Water Resources

P. O. Box 10631  
Jackson, MS 39289-0631  
**WATER WELL DRILLERS LOG**

COUNTY WELL LOCATED <b>Marshall</b>	
WELL NUMBER <b>K 2089</b>	CODED
DATE WELL COMPLETED <b>1-11-99</b>	

PERMIT NUMBER
NAME OF DRILLING FIRM <b>HICKS WELL CO.</b>

NAME & MAILING ADDRESS OF LANDOWNER <b>Virgil Jeffries</b> <b>63 Whitten Rd.</b> <b>Holly Springs, MS 38635</b>			
WELL LOCATION	SEC	TOWNSHIP	RANGE
	<b>14</b>	<b>3</b>	<b>3</b>
DISTANCE	DIRECTION	NEAREST TOWN	
<b>2</b> Miles	<b>NW</b>	of <b>Holly Springs</b>	
OTHER LANDMARK			
WELL PURPOSE: Home, Irrigation, Municipal, Industrial, Fish Pond, etc.			

<b>PUMP DATA</b>		
PUMP TYPE (Circle One): <b>Submersible</b> , Turbine, Jet, Flowing Well, Other (Describe)		
POWER TYPE (Circle One): Electric, Tractor, Diesel, Gasoline, <b>Butane</b> , Other (Describe) H/P		
Pump Capacity (GPM) <b>12</b>	No. of Stages	Setting Depth <b>140</b> FT.
PUMP TEST		
Well yielded _____ GPM with a drawdown of <b>Test</b> ft. after _____ hours of pumping		

<b>WELL DATA</b>		
Well Depth <b>181</b>	Casing Diameter (In.) <b>4</b>	Casing Length (Ft.) <b>171</b>
Type of Casing <b>PVC</b>	Hole Depth <b>181</b>	Depth to Static Water Level <b>110</b>
TYPE OF COMPLETION: (Circle One or More): <b>Gravel Packed</b> , Underreamed, Telescoped, Natural Development, Open Hole, Other (Describe)		
WELL GROUTED TO A DEPTH OF <b>3</b> FEET Type Grout (circle one) <b>Cement</b> , Bentonite, or Mix		

<b>LOG DATA</b>	
TYPE OF LOG RUN (Circle One): Electric, Gamma Ray, Density, Sonic, <b>Neutron</b> , Other (Describe)	
Name of Organization Running Log	

<b>SCREEN DATA</b>		
Diameter - Inches <b>4</b>	Length - Feet <b>10</b>	Slot Size - Inches <b>.014</b>
Screen Type <b>PVC slot</b>	Depth to Bottom - Feet <b>171</b>	


<b>GEOLOGIC DATA (Office Use Only)</b>			
Surface Elev.	Geologic Unit	Unit Thickness	Depth to Top
Subs. SWL	Date	Analysis	Aquifer Test
Driller's Remarks			
Top of Lap Pipe or Reduction in Casing <b>FEET</b> IF TELESCOPED OR MORE THAN ONE SCREEN: USE BACK PAGE			

DESCRIPTION OF FORMATIONS ENCOUNTERED	FROM	TO
<b>Red + White Clay</b>	<b>0</b>	<b>15</b>
<b>Red Sand + Clay</b>	<b>15</b>	<b>75</b>
<b>White Clay + Sand</b>	<b>75</b>	<b>130</b>
<b>White sand.</b>	<b>130</b>	<b>181</b>

FORMATIONS (Continued)	FROM	TO
<b>RECEIVED</b>		
<b>APR 02 1999</b>		
Dept. of Environmental Quality Office of Land & Water Resources		
IF MORE SPACE IS NEEDED, USE BACK		

If well telescopes please  
sketch and show depths.

GROUND LEVEL

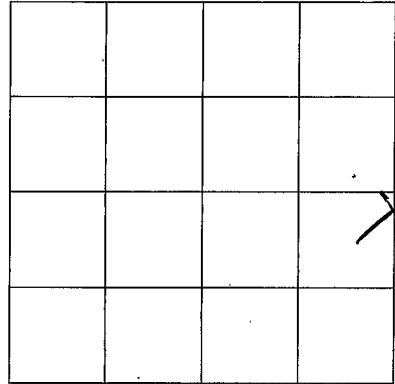

SECTION 14

Please indicate well location X.

ADDITIONAL INFORMATION

If more than one screen,  
show location of each on sketch.