

MISSISSIPPI DEPARTMENT OF ENVIRONMENTAL QUALITY

Office of Land and Water Resources

COUNTY WELL LOCATED
Marshall

WELL NUMBER
K 2039

CODED
2094

DATE WELL COMPLETED
11-10-95

PERMIT NUMBER
HICKS WELL CO.

NAME OF DRILLING FIRM
RT. 1 BOX 157

SENATOBIA, MS 38668

P. O. Box 10631
Jackson, MS 39289-0631
WATER WELL DRILLERS LOG

NAME & MAILING ADDRESS OF LANDOWNER
Pleasant Grove Ch.

Red Banks

MS.

WELL LOCATION: SEC TOWNSHIP RANGE
18 3 N 3 E

DISTANCE DIRECTION NEAREST TOWN
1 1/2 Miles N/E of Red Banks

OTHER LANDMARK

WELL PURPOSE: Home, Irrigation, Municipal, Industrial, Fish Pond, etc.
CHURCH

PUMP DATA

PUMP TYPE (Circle One):
Submersible Turbine, Jet, Flowing Well,
Other (Describe) _____

POWER TYPE (Circle One):
Electric Tractor, Diesel, Gasoline, Butane,
Other (Describe) _____ H/P **1/2**

Pump Capacity (GPM) No. of Stages Setting Depth
10 900 120 FT.

PUMP TEST

Well yielded _____ GPM with
a drawdown of _____ ft.
after _____ hours of pumping

WELL DATA

Well Depth Casing Diameter (In.) Casing Length (Ft.)
160' 4" 150'

Type of Casing Hole Depth Depth to Static Water Level
PVC 160' 100'

TYPE OF COMPLETION: (Circle One or More):
Gravel Packer Underreamed, Telescoped,
Natural Development, Open Hole, Other
(Describe) _____

LOG DATA

TYPE OF LOG RUN (Circle One):
No Log Run, Electric, Gamma Ray, Density, Sonic, Neutron,
Other (Describe) _____

Name of Organization Running Log

WELL GROUTED TO A DEPTH OF **10'** FEET
Type Grout (circle one): Cement, Bentonite, or Mix

GEOLOGIC DATA (Office Use Only)

Surface Elev.	Geologic Unit	Unit Thickness	Depth to Top
Subs. SWL	Date	Analysis	Aquifer Test

Driller's Remarks

Top of Lap Pipe or Reduction in Casing

FEET IF TELESCOPED OR MORE THAN ONE SCREEN: USE BACK PAGE

SCREEN DATA

Diameter - Inches	Length - Feet	Slot Size - Inches
4"	10'	0.13

Screen Type Depth to Bottom - Feet
PVC 10'

DESCRIPTION OF FORMATIONS ENCOUNTERED	FROM	TO
Red Sand	0	80
Sand & Clay	80	100
White Sand	100	160

FORMATIONS (Continued)

FROM	TO

RECEIVED


JAN 16 1995

Dept. of Environmental Quality
Office of Land & Water Resources

IF MORE SPACE IS NEEDED, USE BACK

If well telescopes please
sketch and show depths.

GROUND LEVEL

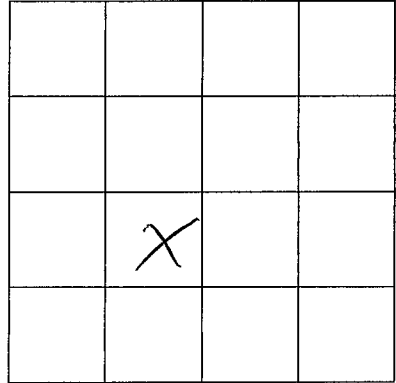

SECTION 18

Please indicate well location X.

ADDITIONAL INFORMATION

If more than one screen,
show location of each on sketch.