

MARSHALL
L 3
12-5-69

MISSISSIPPI
BOARD OF WATER COMMISSIONERS
416 North State Street
Jackson, Mississippi 39201

CODED
CODED
CODED
M... ..

WATER WELL DRILLERS LOG

12-5-69 date well completed Robert W. Wilson firm name county well located

LANDOWNER: Joe Washington
Rt # 2 Holly Springs
Miss. (mailing address)

description of formations encountered	from	to
Red Clay	0	20
Red Sand	20	120
White Clay with sand	120	140
White Sand	140	180

WELL LOCATION:
sec. 3 T. 3 N. R. 2 E
miles of (distance) (direction) (nearest town)

WELL PURPOSE:
(home, irrigation, municipal, industrial)

WELL COMPLETION DATA:

- (1) diameter (inches) 4
- (2) total depth (feet) 180
- (3) static water level (feet) 160 below top of ground.
- (4) casing Pastic 176 (material) (depth)
4 (size) if telescope see back.
- (5) screen 4' 176 (length) (depth to top)
4" Travel Pack (size) (material)
- (6) pump 3/4 15 (HP) (yield gpm)
Electric (type power)
- (7) electric log (yes or no)
- (organization running log)

CODED

(8) how well bottom plugged 4
Plastic Cap


DEC 20 1969

DRILLERS REMARKS:

MISS. BD. OF
WATER COMMISSIONERS

If well telescopes please sketch and show depths.

GROUND LEVEL

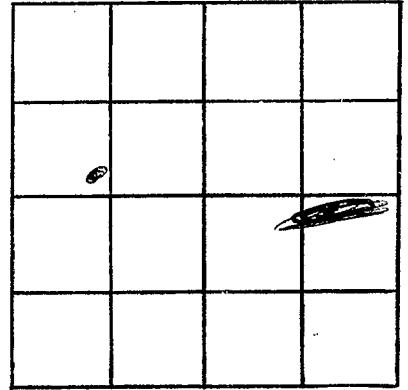

SECTION _____

Please indicate well location X.

ADDITIONAL INFORMATION

If more than one screen,
show locations of each on sketch.