

Marshall
L7

MISSISSIPPI
BOARD OF WATER COMMISSIONERS
416 North State Street
Jackson, Mississippi 39201

CODED

WATER WELL DRILLERS LOG

19 Atkinson & Frost

Marshall

date well completed

firm name

county well located

LANDOWNER:
Colonial Concrete
Holly Springs Miss
(mailing address)

description of formations encountered	from	to
red clay	0	18
red sand	18	50
white clay	50	75
white sand	75	150
white clay	150	160
white sand	160	200

WELL LOCATION:
sec. 5 T. 3 N. R. 1 E
11 miles E of Holly Springs
(distance) (direction) (nearest town)

WELL PURPOSE:
(home, irrigation, municipal, industrial)

WELL COMPLETION DATA:

- (1) diameter (inches) 4 1/2
- (2) total depth (feet) 200
- (3) static water level (feet) _____ below/above top of ground.
- (4) casing PVC (material) 190 (depth)
- _____ (size) If telescope see back.
- (5) screen 10ft (length) 190 (depth to top)
- _____ (size) _____ (material)
- (6) pump 3/4 (HP) 12 (yield gpm)
- Eloc (type power)
- (7) electric log _____ (yes or no)

CODED

(organization running log)


JUL 10 1970

MISS. BD. OF
WATER COMMY

DRILLERS REMARKS: _____

If well telescopes please sketch and show depths.

GROUND LEVEL

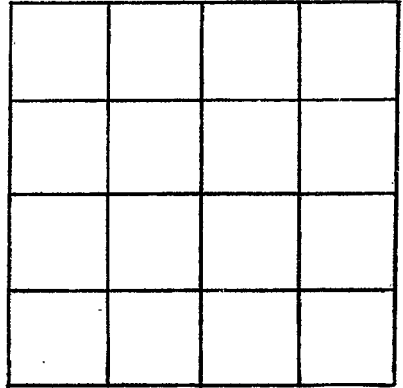

SECTION _____

Please indicate well location X.

ADDITIONAL INFORMATION

If more than one screen, show locations of each on sketch.