

L9

WATER WELL DRILLERS LOG

CODED

6-26-62

Date: 6-26, 1962, Driller: Adams Bros. Co. Inc. County: Marshall

(Name)

(1) Owner of Land: Clay Enterprises, Inc. (Name)

Holly Springs (Address)

(2) Location: 32 32 1/4, 1/4, Sec. T R

miles of (distance) (direction) (Nearest Town)

(3) Topography: (Hilly) (Flat) (Level)

(4) Purpose of Well: (Domestic Irrigation) (Municipal, Industrial, Other)

Information upon completion of well:

(1) Diameter 4 inches.

(2) Total Depth 200 feet.

(3) Water Level 165 feet below top of ground.

(4) Cased to 186, Size

(5) Screen: Size 4", Length 14'

(6) Were any formations sealed against pollution? yes, no.


If YES depth of formation

Why

Drillers Remarks:

Description & Color of Materials Sand, Clay, Red Clay, Shell, etc.	Thick- ness Feet	Depth Feet
top soil	0-15	
red sand	15-50	
white sand	50-150	
fine sand	150-160	
medium white sand	160-180	
coarse white sand	180-200	

CODED

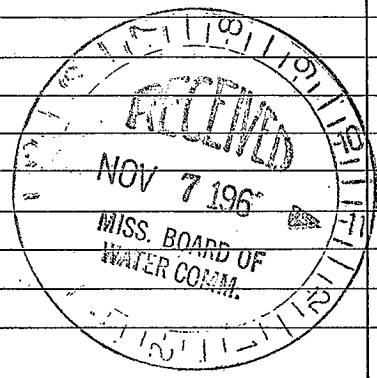

(Use Back Side)

Well No.

